

TATE
D36
2-15-72

MISSISSIPPI
 BOARD OF WATER COMMISSIONERS
 416 North State Street
 Jackson, Mississippi 39201

CODED

WATER WELL DRILLERS LOG

2-15 1972 Harris Bros. Tate
 date well completed firm name county well located.

LANDOWNER: C. G. Youngblood
Rt 2
Coldwater
 (mailing address)

WELL LOCATION:
 sec 26 T N R 5 E
1 miles E of Independence
 (distance) (direction) (nearest town)

description of formations encountered	from	to
<u>top soil</u>	<u>0</u>	<u>15</u>
<u>red sand</u>	<u>15</u>	<u>40</u>
<u>clay + sand</u>	<u>40</u>	<u>85</u>
<u>Coarse sand</u>	<u>85</u>	<u>100</u>

WELL PURPOSE: None
 (home, irrigation, municipal, industrial)

WELL COMPLETION DATA:

(1) diameter (inches) 4

(2) total depth (feet) 100

(3) static water level (feet) 60 below top of ground. above

(4) casing Plastic 93
 (material) (depth)

4 if telescope see back.
 (size)

(5) screen 7 93
 (length) (depth to top)

008 Plastic
 (size) (material)

(6) pump 3/4 10
 (HP) (yield gpm)

elec.
 (type power)

(7) electric log no
 (yes or no)

(organization running log)

(8) how well bottom plugged Solid

CODED


NOV - 7 1972

MISS. Bd.
 WATER COMMISSIONERS

DRILLERS REMARKS:

If well telescopes please sketch and show depths.

GROUND LEVEL

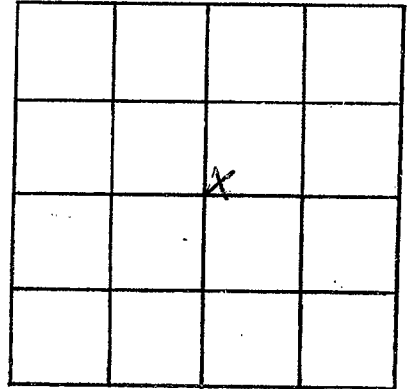

SECTION 26

Please indicate well location X.

ADDITIONAL INFORMATION

If more than one screen, show locations of each on sketch.