

TATE  
D37  
4-1-72

MISSISSIPPI  
BOARD OF WATER COMMISSIONERS  
416 North State Street  
Jackson, Mississippi 39201

**CODED**

WATER WELL DRILLERS LOG

~~4-1~~ 1972 Harris Bros. Tate  
date well completed firm name county well located

| LANDOWNER: <u>Mach Darnell</u>  | description of formations encountered | from       | to         |
|---|---------------------------------------|------------|------------|
| <u>Rt. 3</u>  | <u>top soil</u>                       | <u>0</u>   | <u>15</u>  |
| <u>Coldwater</u><br>(mailing address)   | <u>clay + sand</u>                    | <u>15</u>  | <u>100</u> |
| WELL LOCATION:<br>sec <u>30</u> T <u>4</u> N R <u>5</u> E<br><u>1 1/2</u> miles <u>N</u> of <u>Beato</u><br>(distance) (direction) (nearest town) | <u>course sand</u>                    | <u>100</u> | <u>120</u> |
| WELL PURPOSE: <u>Home</u><br>(home, irrigation, municipal, industrial)  |                                       |            |            |
| WELL COMPLETION DATA:   |                                       |            |            |
| (1) diameter (inches) <u>4</u>  |                                       |            |            |
| (2) total depth (feet) <u>120</u>   |                                       |            |            |
| (3) static water level (feet) <u>60</u> <small>(below above top of ground)</small>  |                                       |            |            |
| (4) casing <u>Plastic</u> , <u>113</u><br>(material) (depth)  |                                       |            |            |
| <u>4</u> if telescope see back.<br>(size)   |                                       |            |            |
| (5) screen <u>7</u> , <u>113</u><br>(length) (depth to top)   |                                       |            |            |
| <u>008</u> , <u>Plastic</u><br>(size) (material)  |                                       |            |            |
| (6) pump <u>3/4</u> , <u>7</u><br>(HP) (yield gpm)  |                                       |            |            |
| <u>elec.</u><br>(type power)  |                                       |            |            |
| (7) electric log <u>No</u><br>(yes or no)   |                                       |            |            |
| <u></u><br>(organization running log)   |                                       |            |            |
| (8) how well bottom plugged <u>Solid</u>  |                                       |            |            |
| DRILLERS REMARKS:   |                                       |            |            |


**CODED**

AUG - 7 1972

MISS. BD. OF  
WATER COMMISSIONERS

If well telescopes please sketch and show depths.

GROUND LEVEL

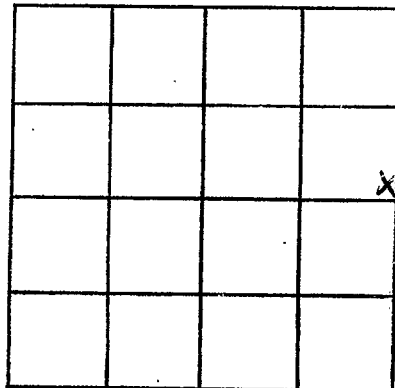

SECTION 30

Please indicate well location X.

ADDITIONAL INFORMATION

If more than one screen, show locations of each on sketch.