

TATE
D 38
3-25-72

MISSISSIPPI
BOARD OF WATER COMMISSIONERS
416 North State Street
Jackson, Mississippi 39201

CODED

WATER WELL DRILLERS LOG

3-25 1972
date well completed

Harris Bros. Tate
firm name

county well located

LANDOWNER: R. E. Patrick
Rt. 2
Coldwater
(mailing address)

description of formations encountered

from

to

| | | |
|-------------|-----|-----|
| top soil | 0 | 20 |
| white clay | 20 | 45 |
| clay + sand | 45 | 110 |
| Coarse sand | 110 | 130 |

WELL LOCATION:

sec 34 T 4 N R 5 E W
In Beth
miles of (nearest town)

WELL PURPOSE: home
(home, irrigation, municipal, industrial)

WELL COMPLETION DATA:

- (1) diameter (inches) 4
- (2) total depth (feet) 130
- (3) static water level (feet) ~~130~~ 80 below top of ground.
- (4) casing Plastic, 116 (material) (depth)
- 4 (size) if telescope see back.
- (5) screen 14 (length) 116 (depth to top)
- 008 Plastic (size) (material)
- (6) pump 1 (HP) 15 (yield gpm)
- elec. (type power)
- (7) electric log no (yes or no)

CODED

(organization running log)

AUG - 7 1972


(8) how well bottom plugged solid

MISS. BD. OF
WATER COMM.

DRILLERS REMARKS:

If well telescopes please sketch and show depths.

GROUND LEVEL

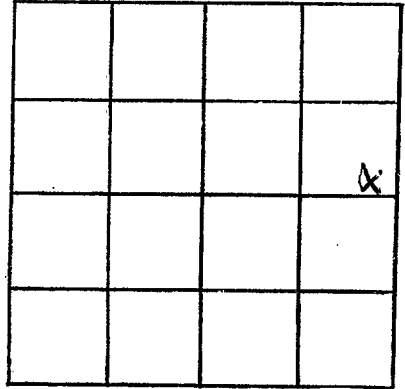

SECTION 31

Please indicate well location X.

ADDITIONAL INFORMATION

If more than one screen,
show locations of each on sketch.