

TATE
D39
1-25-72

MISSISSIPPI
 BOARD OF WATER COMMISSIONERS
 416 North State Street
 Jackson, Mississippi 39201

CODED

WATER WELL DRILLERS LOG

1-25 1972 Harris Bros. Tate
 date well completed firm name county well located

LANDOWNER: Pete Patrick
Rt. 3
Coldwater
 (mailing address)

WELL LOCATION:
 sec 28 T 4 N R 5 E
2 1/2 miles NE of Bett
 (distance) (direction) (nearest town)

| description of formations encountered | from | to |
|---------------------------------------|------------|------------|
| <u>top soil</u> | <u>0</u> | <u>20</u> |
| <u>clay + sand</u> | <u>20</u> | <u>145</u> |
| <u>Coarse sand</u> | <u>145</u> | <u>170</u> |

WELL PURPOSE: Subdivision
 (home, irrigation, municipal, industrial)

WELL COMPLETION DATA:

(1) diameter (inches) 4

(2) total depth (feet) 170

(3) static water level (feet) 80 ^{below} above top of ground.

(4) casing Plastic, 156
 (material) (depth)

4 if telescope see back.
 (size)

(5) screen 14, 156
 (length) (depth to top)

008, Plastic
 (size) (material)

(6) pump 2, 30
 (HP) (yield gpm)

elec.
 (type power)

(7) electric log no
 (yes or no)

CODED

(organization running log)

(8) how well bottom plugged Salicy


AUG - 7 1972

DRILLERS REMARKS:

MISS. BO. OF
 WATER COMM.

If well telescopes please sketch and show depths.

GROUND LEVEL

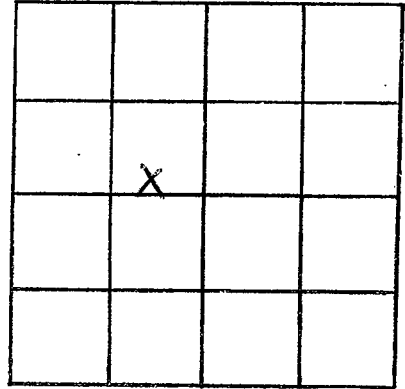

SECTION 28

Please indicate well location X.

ADDITIONAL INFORMATION

Lined area for additional information.

If more than one screen, show locations of each on sketch.