

TATE  
D 40  
4-20-72

MISSISSIPPI  
BOARD OF WATER COMMISSIONERS  
416 North State Street  
Jackson, Mississippi 39201

**CODED**

WATER WELL DRILLERS LOG

4-20 1972 Harris Bros Tate  
date well completed firm name county well located

LANDOWNER: Richard Williams  
Rt. 3  
Coldwater  
(mailing address)

WELL LOCATION:  
sec. 8 T. 4 N. R. 5 E.  
3/4 miles W Wakefield  
(distance) (direction) (nearest town)

WELL PURPOSE: none  
(home, irrigation, municipal, industrial)

- WELL COMPLETION DATA:
- (1) diameter (inches) 4
  - (2) total depth (feet) 100
  - (3) static water level (feet) 60  below  above top of ground.
  - (4) casing plastic 93'  
(material) (depth)  
4  
(size) if telescope see back.
  - (5) screen 7' 93'  
(length) (depth to top)  
008 plastic  
(size) (material)
  - (6) pump 3/4 10  
(HP) (yield gpm)  
elec.  
(type power)
  - (7) electric log NO  
(yes or no)
  - (organization running log)
  - (8) how well bottom plugged solid

description of formations encountered	depth	
	from	to
top soil	0	15
red sand	15	40
clay + sand	40	85
coarse sand	85	100

**CODED**


041 18 1972

DRILLERS REMARKS:

MISS. RD. OF  
WATER COMM.

If well telescopes please sketch and show depths.

GROUND LEVEL

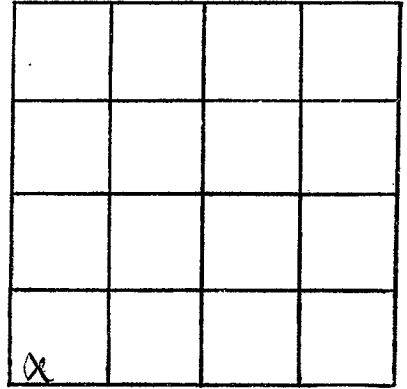

SECTION 8

Please indicate well location X.

ADDITIONAL INFORMATION

If more than one screen,  
show locations of each on sketch.