

TATE
D42
10-26-72

MISSISSIPPI
BOARD OF WATER COMMISSIONERS
416 North State Street
Jackson, Mississippi 39201

CODED

WATER WELL DRILLERS LOG

10-26 1972 Hicks Brothers TATE
date well completed firm name county well located

LANDOWNER: JOHN ECHOLS
PT. 2 COLDWATER
(mailing address)

description of formations encountered	from	to
Red sand	0	4.5
Red sandy clay	4.5	7.5
White sand	7.5	18.5

WELL LOCATION:
sec. 20 T. 4 N R. 5 E
(S) (W)
1.5 miles E of Coldwater
(distance) (direction) (nearest town)

WELL PURPOSE:
(home, irrigation, municipal, industrial)

WELL COMPLETION DATA:

(1) diameter (inches) 4"

(2) total depth (feet) 15.5

(3) static water level (feet) 10.6 below above top of ground.

(4) casing Plastic, 1.9 (material) (depth)
If telescope see back.
(size)

(5) screen 6 ft, 6 ft (length) (depth to top)
1.5" Plastic Gravel (size) (material)

(6) pump 3/4, 10 (HP) (yield gpm)
220 EIBC (type power)

(7) electric log NO (yes or no)
(organization running log)

(8) how well bottom plugged CSD

CODED


NOV - 3 1972

DRILLERS REMARKS:

WATER

If well telescopes please sketch and show depths.

GROUND LEVEL

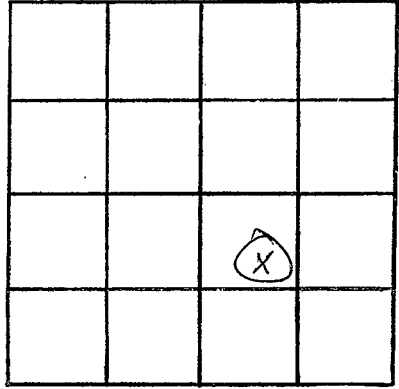

SECTION _____

Please indicate well location X.

ADDITIONAL INFORMATION

Lined area for additional information.

If more than one screen, show locations of each on sketch.