

TATE
D 43
11-28-72

MISSISSIPPI
BOARD OF WATER COMMISSIONERS
416 North State Street
Jackson, Mississippi 39201

CODED

WATER WELL DRILLERS LOG

11-28-1972
date well completed

Bob Smith
firm name

Tate
county well located


LANDOWNER:	description of formations encountered	from	to
Alba m ^c Farland	clay lint		2
Wabique, miss. (mailing address)	Red sand & gravel	7	30
WELL LOCATION: sec. 7 8 T. 4 N. R. 6 5 1 miles North of (Wabique) (distance) (direction) (nearest town)	coarse white sand	30	85
WELL PURPOSE: None (home, irrigation, municipal, industrial)			
WELL COMPLETION DATA: (1) diameter (inches) 4 (2) total depth (feet) 85 (3) static water level (feet) 53 below top of ground. (4) casing Blastic, 85 (material), (depth) 4" (size) if telescope see back. (5) screen 20 (length), 65 (depth to top) 4 (size), Blastic (material) (6) pump 1/3 (HP), 10 (yield gpm) Elec. (type power) (7) electric log no (yes or no) (organization running log) (8) how well bottom plugged plugged			
DRILLERS REMARKS:			

CODED

FEB 28 1973

If well telescopes please sketch and show depths.

GROUND LEVEL

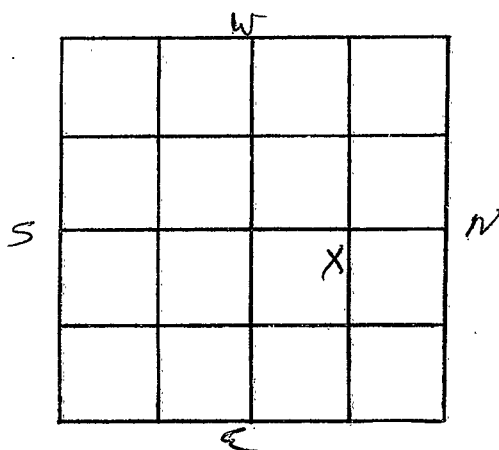

SECTION 8

Please indicate well location X.

ADDITIONAL INFORMATION

If more than one screen, show locations of each on sketch.