

TATE
D44
2-10-73

MISSISSIPPI
BOARD OF WATER COMMISSIONERS
416 North State Street
Jackson, Mississippi 39201

CODED

WATER WELL DRILLERS LOG

2-10 1973 Harris Bros. Tate
date well completed firm name county well located

LANDOWNER: C. F. James
Rt. 3
Coldwater
(mailing address)

description of formations encountered	from	to
top soil	0	15
red clay	15	45
clay + sand	45	95
coarse sand	95	110

WELL LOCATION:
sec 29 T. 4 N. R. 5 E
1 1/2 miles N of Ret
(distance) (direction) (nearest town)

WELL PURPOSE: none
(home, irrigation, municipal, industrial)

WELL COMPLETION DATA:

(1) diameter (inches) 4

(2) total depth (feet) 110

(3) static water level (feet) 60 below top of ground.

(4) casing plastic, 103
(material) (depth)
4 (size) if telescope see back.

(5) screen 7, 103
(length) (depth to top)
008, plastic
(size) (material)

(6) pump 3/4, 10
(HP) (yield gpm)
elec.
(type power)

(7) electric log no
(yes or no)

(organization running log)

(8) how well bottom plugged solid


CODED

DRILLERS REMARKS:

MAR 20 1973

If well telescopes please sketch and show depths.

GROUND LEVEL

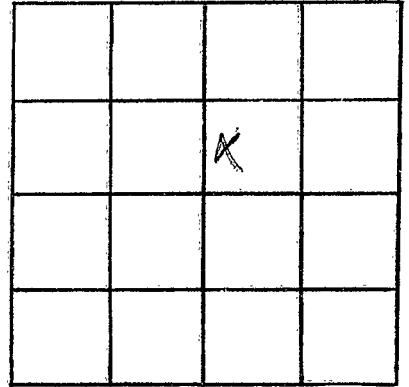

SECTION 29

Please indicate well location X.

ADDITIONAL INFORMATION

If more than one screen, show locations of each on sketch.