

TATE  
D47  
3-14-73

MISSISSIPPI  
BOARD OF WATER COMMISSIONERS  
416 North State Street  
Jackson, Mississippi 39201

CODED

WATER WELL DRILLERS LOG

3-14-1973 date well completed      Bob Smith firm name      Tate county well located

LANDOWNER: Clarence Peyton  
Wakfield, Miss.  
(mailing address)

description of formations encountered	from	to
clay dirt		8
red sand + gravel	8	30
white sand	30	85
white clay	85	89
white sand	89	120

WELL LOCATION:  
sec. 9 T. 4 N. R. 5 E.  
1/2 miles North of Wakfield  
(distance) (direction) (nearest town)

WELL PURPOSE: None  
(home, irrigation, municipal, industrial)

- WELL COMPLETION DATA:
- (1) diameter (inches) 4
  - (2) total depth (feet) 120
  - (3) static water level (feet) 70 below above top of ground.
  - (4) casing Plastic 120  
(material) (depth)  
(size) if telescope see back.
  - (5) screen 20 100  
(length) (depth to top)  
4" Plastic  
(size) (material)
  - (6) pump 1/3 10  
(HP) (yield gpm)  
Electric  
(type power)
  - (7) electric log no  
(yes or no)  
(organization running log)
  - (8) how well bottom plugged plugged

APR 18 1973


DRILLERS REMARKS:

APR 18 1973

MISSISSIPPI  
BOARD OF WATER COMMISSIONERS  
416 NORTH STATE STREET  
JACKSON, MISSISSIPPI 39201

If well telescopes please sketch and show depths.

GROUND LEVEL

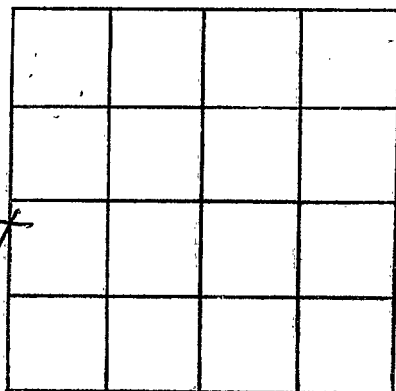

SECTION 9

Please indicate well location X.

ADDITIONAL INFORMATION

If more than one screen,  
show locations of each on sketch.