

TATE  
D 48  
4-9-73

MISSISSIPPI  
BOARD OF WATER COMMISSIONERS  
416 North State Street  
Jackson, Mississippi 39201

CODED

WATER WELL DRILLERS LOG

4-9-1973 date well completed  
Hicks Bros Well Co. firm name  
Tate county well located

LANDOWNER: <u>Charlie Martin</u>	description of formations encountered	from	to
<u>Route 5</u> <u>Holly Springs miss</u> (mailing address)			
	<u>Red clay</u>	<u>0</u>	<u>15</u>
	<u>Red sand</u>	<u>15</u>	<u>90</u>
	<u>White sand</u>	<u>90</u>	<u>180</u>

WELL LOCATION:  
sec 5 T 4 N R 5 E  
16 miles E of Senatobia  
(distance) (direction) (nearest town)

WELL PURPOSE: Home  
(home, irrigation, municipal, industrial)

- WELL COMPLETION DATA:
- (1) diameter (inches) 4 in
  - (2) total depth (feet) 180
  - (3) static water level (feet) 149 below above top of ground.
  - (4) casing Plastic, 180,  
(material) (depth)  
         if telescope see back.  
(size)
  - (5) screen 4 ft, 176  
(length) (depth to top)  
         (size) (material)
  - (6) pump 3/4 10  
(HP) (yield gpm)  
Prestas 200  
(type power)
  - (7) electric log No  
(yes or no)  
         (organization running log)
  - (8) how well bottom plugged Cap


CODED

DRILLERS REMARKS:         

APR 10 1973

If well telescopes please sketch and show depths.

GROUND LEVEL

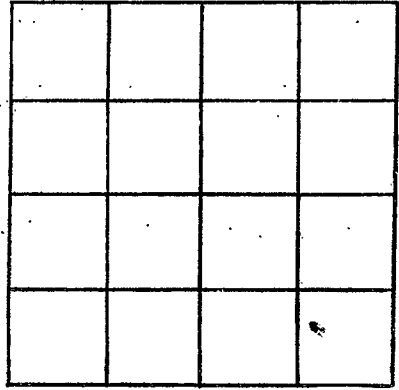

SECTION \_\_\_\_\_

Please indicate well location X.

ADDITIONAL INFORMATION

A series of horizontal lines for recording additional information, starting below the 'ADDITIONAL INFORMATION' header and extending to the bottom of the page.

If more than one screen, show locations of each on sketch.