

MISSISSIPPI
BOARD OF WATER COMMISSIONERS
416 North State Street
Jackson, Mississippi 39201

CODED

WATER WELL DRILLERS LOG

TATE
D 49
5-27-73
5-27-73
~~4-28~~

1973 ~~1973~~ *Lick Bros. Well Co.* ~~ATKINS~~ *Jatt*
firm name county well located

date well completed

firm name

county well located

LANDOWNER:

Loyce Shadders
RT# Box 274, Coldwater
(mailing address) *Miss*

description of formations encountered

from to

<i>Red Clay</i>	<i>0</i>	<i>15</i>
<i>Red Sand</i>	<i>15</i>	<i>60</i>
<i>white Sand</i>	<i>60</i>	<i>155</i>

WELL LOCATION:

sec. *28* T *4* N R *5* E
14 miles *E* of *Coldwater*
(distance) (direction) (nearest town)

WELL PURPOSE: *Home*
(home, irrigation, municipal, industrial)

WELL COMPLETION DATA:

- (1) diameter (inches) *4 1/2 in*
- (2) total depth (feet) *135*
- (3) static water level (feet) *106* below above top of ground.
- (4) casing *Plastic*, *135*
(material) (depth)
- (size) if telescope see back.
- (5) screen *4 ft*, *152*
(length) (depth to top)
- 4 in*; *Gravel*
(size) (material)
- (6) pump *3/4* *10*
(HP) (yield gpm)
- Electric's 220*
(type power)
- (7) electric log *no*
(yes or no)

CODED

(organization running log)


(a) how well bottom plugged *Cap*

REMARKS:

JUN 15 1973

If well telescopes please sketch and show depths.

GROUND LEVEL

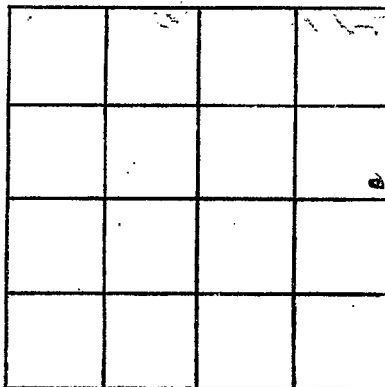

SECTION 28

Please indicate well location X.

ADDITIONAL INFORMATION

If more than one screen, show locations of each on sketch.