

TATE
D 52
5-22-73

MISSISSIPPI **CODED**
BOARD OF WATER COMMISSIONERS
416 North State Street
Jackson, Mississippi 39201
WATER WELL DRILLERS LOG

5-28-1973 *Bob Hill* *Jate*
date well completed firm name county well located

LANDOWNER:
C Lorne May
Wabkill
(mailing address)

WELL LOCATION:
sec. 9 T. 4 N. R. 5 E. (S) (W)
1 miles East of Wabkill
(distance) (direction) (nearest town)

WELL PURPOSE: Home
(home, irrigation, municipal, industrial)

WELL COMPLETION DATA:

- (1) diameter (inches) 4
- (2) total depth (feet) 165
- (3) static water level (feet) 75 below top of ground.
- (4) casing Plastic 165
(material) (depth)
_____ If telescope see back.
(size)
- (5) screen 20 145
(length) (depth to top)
4 Plastic
(size) (material)
- (6) pump 1/3 0
(HP) (yield gpm)
Elec
(type power)
- (7) electric log no
(yes or no)
(organization running log)
- (8) how well bottom plugged plugged


description of formations encountered	from	to
<i>clay</i>	<i>10</i>	<i>10</i>
<i>Red sand</i>	<i>10</i>	<i>35</i>
<i>sand + gravel</i>	<i>35</i>	<i>50</i>
<i>blue clay</i>	<i>50</i>	<i>75</i>
<i>white sand</i>	<i>75</i>	<i>98</i>
<i>white clay</i>	<i>98</i>	<i>115</i>
<i>white sand</i>	<i>115</i>	<i>125</i>
<i>white clay</i>	<i>125</i>	<i>145</i>
<i>white sand</i>	<i>145</i>	<i>165</i>

DRILLERS REMARKS:

SEP 27 1973

If well telescopes please sketch and show depths.

GROUND LEVEL

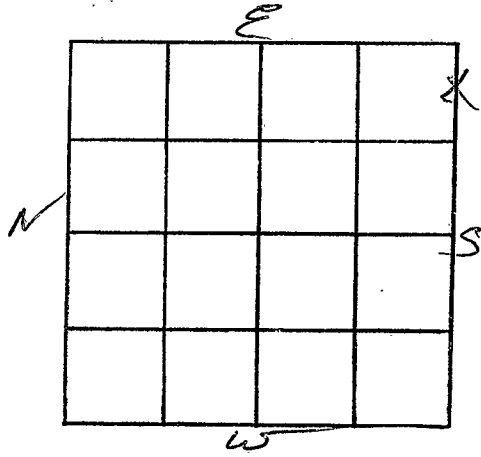

SECTION 9

Please indicate well location X.

ADDITIONAL INFORMATION

If more than one screen,
show locations of each on sketch.