

TATE  
D53  
6-16-73

MISSISSIPPI  
BOARD OF WATER COMMISSIONERS  
416 North State Street  
Jackson, Mississippi 39201

CODED

WATER WELL DRILLERS LOG

6-16-1973 date well completed      Bob Hill firm name      Jato county well located


LANDOWNER:	description of formations encountered	from	to
B. A. Stanton	Clay Silt	10	10
Chickamauga (mailing address)	Red clay	10	90
WELL LOCATION: sec. 29 T 4 N R 5 E 2 1/2 miles South of Water Street (distance) (direction) (nearest town)	coarse Red sand & gravel	90	130
WELL PURPOSE: Home (home, irrigation, municipal, industrial)			
WELL COMPLETION DATA:			
(1) diameter (inches) 4			
(2) total depth (feet) 130			
(3) static water level (feet) 54 below top of ground.			
(4) casing Plastic 130 (material) (depth)			
(size) if telescope see back.			
(5) screen 30 110 (length) (depth to top)			
(size) 4 Plastic (material)			
(6) pump 1/2 10 (HP) (yield gpm)			
(type power) E See			
(7) electric log 70 (yes or no)			
(organization running log)			
(8) how well bottom plugged plugged			
DRILLERS REMARKS:			

CODED

SEP 27 1973

If well telescopes please sketch and show depths.

GROUND LEVEL

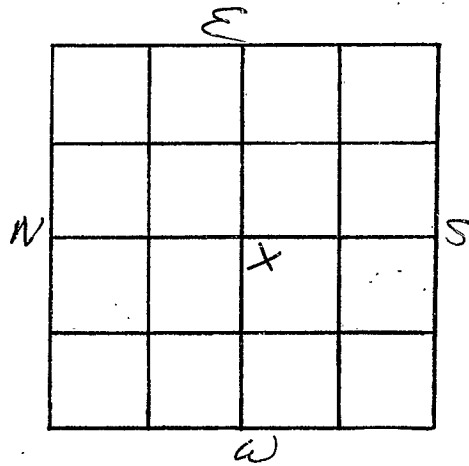

SECTION 29

Please indicate well location X.

ADDITIONAL INFORMATION

If more than one screen, show locations of each on sketch.