

LATE
D 54
3-26-73

MISSISSIPPI
BOARD OF WATER COMMISSIONERS
416 North State Street
Jackson, Mississippi 39201

WATER WELL DRILLERS LOG

CODED

3-26 1973 date well completed
Harris Bros. firm name
Late county well located

LANDOWNER: Robert H. Davis Rt. 3 Coldwater (mailing address)	description of formations encountered	from	to
	top soil	0	15
	red clay + sand	15	50
	fine sand	50	105
	Coarse sand	105	120
WELL LOCATION: sec. 29 T. 4 N. R. 5 E. 3 1/2 miles E of Independence (distance) (direction) (nearest town)			
WELL PURPOSE: home (home, irrigation, municipal, industrial)			
WELL COMPLETION DATA: (1) diameter (inches) 4 (2) total depth (feet) 120 (3) static water level (feet) 80 <u>below</u> top of ground. (4) casing <u>Plastic</u> , 113' (material) (depth) 4 (size) If telescope see back. (5) screen 7' 113' (length) (depth to top) 008, Plastic (size) (material) (6) pump 3/4 10 (HP) (yield gpm) <u>elec.</u> (type power) (7) electric log <u>no</u> (yes or no) (organization running log) (8) how well bottom plugged <u>solid</u>			
DRILLERS REMARKS:			


CODED

APR 2 1973

MISS. Bd. of
Water Comm.

If well telescopes please sketch and show depths.

GROUND LEVEL

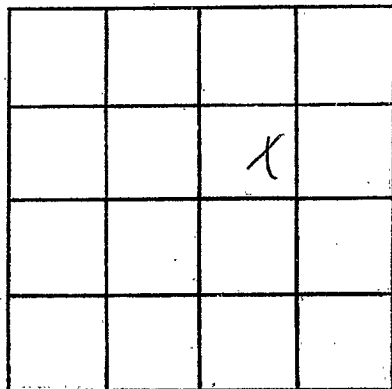

SECTION _____

Please indicate well location X.

ADDITIONAL INFORMATION

If more than one screen, show locations of each on sketch.