

TATE
D 55
4-4-73

MISSISSIPPI
BOARD OF WATER COMMISSIONERS
416 North State Street
Jackson, Mississippi 39201
WATER WELL DRILLERS LOG

CODED

4-4 date well completed 1923 Harris Bros. firm name Tate county well located

LANDOWNER: ~~John W. Blanton~~
John W. Blanton
Rt. 3 Coldwater
(mailing address)

description of formations encountered	from	to
top soil	0	15
red sand + clay	15	45
fine sand	45	95
coarse sand	95	110

WELL LOCATION:
sec. 29 T 4 N R S E
3 1/2 miles E of Coldwater
(distance) (direction) (nearest town)

WELL PURPOSE: home
(home, irrigation, municipal, industrial)

- WELL COMPLETION DATA:
- (1) diameter (inches) 4
 - (2) total depth (feet) 110
 - (3) static water level (feet) 70 below top of ground.
 - (4) casing Plastic, 103 (material) (depth)
 - 4 (size) if telescope see back.
 - (5) screen 7' (length) 103 (depth to top)
 - 008 Plastic (size) (material)
 - (6) pump 3/4 (HP) 10 (yield gpm)
 - elec. (type power)
 - (7) electric log NO (yes or no)
 - (organization running log)
 - (8) how well bottom plugged solid

CODED


DRILLERS REMARKS:

DATE 2/28/73

WATER

If well telescopes please sketch and show depths.

GROUND LEVEL

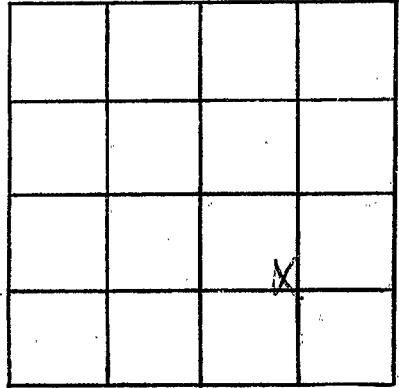

SECTION _____

Please indicate well location X.

ADDITIONAL INFORMATION

If more than one screen, show locations of each on sketch.