

TATE
D 56
5-8-73

MISSISSIPPI
BOARD OF WATER COMMISSIONERS
416 North State Street
Jackson, Mississippi 39201

CODED

WATER WELL DRILLERS LOG

5-8 1973 Harris Bros. Tate
date well completed firm name county well located

LANDOWNER: <i>C. N. Brooks</i>	description of formations encountered	from	to
<i>pt. 3</i>	<i>top soil</i>	<i>0</i>	<i>20</i>
<i>Coldwater</i> (mailing address)	<i>sand + clay</i>	<i>20</i>	<i>110</i>
WELL LOCATION: sec. <i>18</i> T. <i>4</i> N. R. <i>5</i> E <i>in near Garden</i> (distance) (direction) (nearest town)	<i>Coarse sand</i>	<i>110</i>	<i>130</i>
WELL PURPOSE: <i>home</i> (home, irrigation, municipal, industrial)			
WELL COMPLETION DATA:			
(1) diameter (inches) <i>4</i>			
(2) total depth (feet) <i>130</i>			
(3) static water level (feet) <i>90</i> <small>below above</small> top of ground.			
(4) casing <i>Plastic</i> , <i>123</i> (material) (depth) <i>4</i> (size) If telescope see back.			
(5) screen <i>7</i> , <i>123</i> (length) (depth to top)			
<i>208 Plastic</i> (size) (material)			
(6) pump <i>3/4</i> , <i>10</i> (HP) (yield gpm)			
<i>elec.</i> (type power)			
(7) electric log <i>no</i> (yes or no)			
(organization running log)			
(8) how well bottom plugged <i>solid</i>			
DRILLERS REMARKS:			


CODED

USE 20 1973

MISS. BD. OF
WATER COM.

If well telescopes please sketch and show depths.

GROUND LEVEL

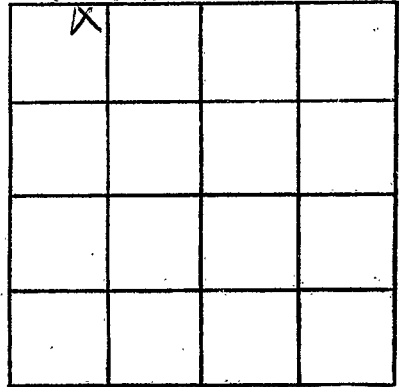

SECTION 18

Please indicate well location X.

ADDITIONAL INFORMATION

If more than one screen, show locations of each on sketch.