

IATE  
D58  
6-10-73

MISSISSIPPI  
 BOARD OF WATER COMMISSIONERS  
 416 North State Street  
 Jackson, Mississippi 39201

WATER WELL DRILLERS LOG

**CODED**

6-10 1973 Harris Bros. Iate  
 date well completed firm name county well located

LANDOWNER: J. S. Guggan  
Rt. #4  
Coldwater  
 (mailing address)

description of formations encountered	from	to
<u>top soil</u>	<u>0</u>	<u>20</u>
<u>clay + sand</u>	<u>20</u>	<u>110</u>
<u>coarse sand</u>	<u>110</u>	<u>120</u>

WELL LOCATION:  
 sec 29 T 4 N R 5 E  
1 miles N of Beth  
 (distance) (direction) (nearest town)

WELL PURPOSE: home  
 (home, irrigation, municipal, industrial)

- WELL COMPLETION DATA:
- (1) diameter (inches) 4
  - (2) total depth (feet) 120
  - (3) static water level (feet) 80 ~~below~~ above top of ground.
  - (4) casing Plastic, 113  
 (material) (depth)  
4 if telescope see back.  
 (size)
  - (5) screen 7, 113  
 (length) (depth to top)  
008, Plastic  
 (size) (material)
  - (6) pump 3/4, 10  
 (HP) (yield gpm)  
elec  
 (type power)
  - (7) electric log no  
 (yes or no)
- (organization running log)
- (8) how well bottom plugged solid


**CODED**

DRILLERS REMARKS:

DEC 23 1973

If well telescopes please sketch and show depths.

GROUND LEVEL

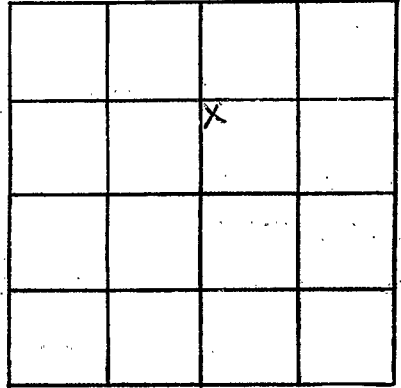

SECTION \_\_\_\_\_

Please indicate well location X.

ADDITIONAL INFORMATION

If more than one screen, show locations of each on sketch.