

LATE
D59
6-10-73

MISSISSIPPI
BOARD OF WATER COMMISSIONERS
416 North State Street
Jackson, Mississippi 39201

CODED

WATER WELL DRILLERS LOG

6-10 1973 Harris Bros. Late
date well completed firm name county well located

LANDOWNER: J.C. Ward
Rt. #4
Coldwater
(mailing address)

description of formations encountered	from	to
<u>top soil</u>	<u>0</u>	<u>20</u>
<u>clay + sand</u>	<u>20</u>	<u>110</u>
<u>Coarse sand</u>	<u>110</u>	<u>120</u>

WELL LOCATION:
sec 24 T 4 N R 5 E
1 miles N of Reto
(distance) (direction) (nearest town)

WELL PURPOSE: none
(home, irrigation, municipal, industrial)

- WELL COMPLETION DATA:
- (1) diameter (inches) 4
 - (2) total depth (feet) 120
 - (3) static water level (feet) 80 ^{below} above top of ground.
 - (4) casing Plastic, 113
(material) (depth)
4 if telescope see back.
(size)
 - (5) screen 7, 113
(length) (depth to top)
008, Plastic
(size) (material)
 - (6) pump 3/4, 10
(HP) (yield gpm)
elec.
(type power)
 - (7) electric log no
(yes or no)

(organization running log)
(8) how well bottom plugged solid

DRILLERS REMARKS:


CODED

JUN 10 1973

MISS. BD. OF
WATER COMMISSIONERS

If well telescopes please sketch and show depths.

GROUND LEVEL

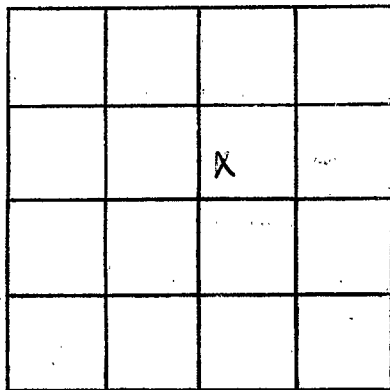

SECTION 29

Please indicate well location X.

ADDITIONAL INFORMATION

If more than one screen, show locations of each on sketch.