

LATE
D 60
8-20-73

MISSISSIPPI
BOARD OF WATER COMMISSIONERS
416 North State Street
Jackson, Mississippi 39201

CODED

WATER WELL DRILLERS LOG

8-20 1973 Harris Bros. Late
date well completed firm name county well located

LANDOWNER:
Robert E. McIlwain
Rt. 3 Coldwater
(mailing address)

description of formations encountered	from	to
top soil	0	15
clays sand	15	85
coarse sand	85	100

WELL LOCATION:
sec 29 T 4 N R 5 E
1 miles N of Beth
(distance) (direction) (nearest town)

WELL PURPOSE: none
(home, irrigation, municipal, industrial)

- WELL COMPLETION DATA:
- (1) diameter (inches) 4
 - (2) total depth (feet) 100
 - (3) static water level (feet) 60 ^{below} above top of ground.
 - (4) casing Plastic, 93
(material) (depth)
4 (size) if telescope see back.
 - (5) screen 7, 93
(length) (depth to top)
008 Plastic
(size) (material)
 - (6) pump 3/4, 10
(HP) (yield gpm)
elec.
(type power)
 - (7) electric log no
(yes or no)
 - (organization running log)
 - (8) how well bottom plugged solid


CODED

DRILLERS REMARKS:

OCT 23 1973

If well telescopes please sketch and show depths.

GROUND LEVEL

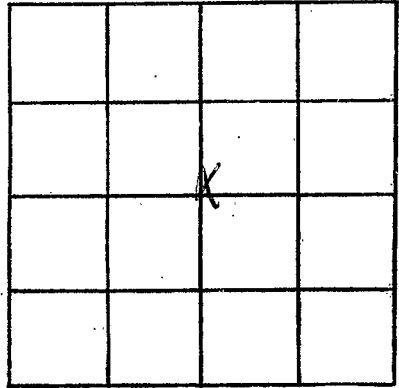

SECTION 29

Please indicate well location X.

ADDITIONAL INFORMATION

If more than one screen, show locations of each on sketch.