

TATE  
DL2  
12-21-73

MISSISSIPPI  
BOARD OF WATER COMMISSIONERS  
416 North State Street  
Jackson, Mississippi 39201

CODED

WATER WELL DRILLERS LOG

12-21-73 date well completed      Hicks Bros. Well Co. firm name      Tate county well located

LANDOWNER: Leon Havers  
Rt 3 Box 245  
Coldwater, Miss.  
(mailing address)

description of formations encountered      from      to

WELL LOCATION:  
sec 21 T 4 N R 5 E  
17 miles SE of Coldwater  
(distance) (direction) (nearest town)

WELL PURPOSE: Home  
(home, irrigation, municipal, industrial)

- WELL COMPLETION DATA:
- (1) diameter (inches) 4 in.
  - (2) total depth (feet) 140
  - (3) static water level (feet) 85 below above top of ground.
  - (4) casing Plastic, 140,  
(material) (depth)  
         if telescope see back.  
(size)
  - (5) screen 4 in., 136  
(length) (depth to top)  
4 in., Steel  
(size) (material)
  - (6) pump 1/2 8.5 gpm  
(HP) (yield gpm)  
Electric, 220  
(type power)
  - (7) electric log no  
(yes or no)
  - (organization running log)
  - (8) how well bottom plugged Cap

CODED


DEC 26 1973

DRILLERS REMARKS:

MISSISSIPPI  
BOARD OF WATER COMMISSIONERS

If well telescopes please sketch and show depths.

GROUND LEVEL

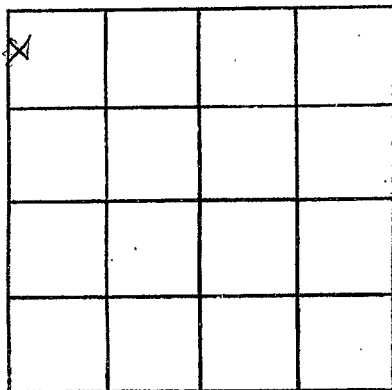

SECTION 21

Please indicate well location X.

ADDITIONAL INFORMATION

Lined area for additional information.

If more than one screen, show locations of each on sketch.