

MISSISSIPPI
BOARD OF WATER COMMISSIONERS
416 North State Street
Jackson, Mississippi 39201

CODED

WATER WELL DRILLERS LOG

TATE
DL3
11-15-73

11-15 date well completed 1973 firm name Harris Bros. Tate county well located

LANDOWNER: <u>M. H. Palmer</u>	description of formations encountered	from	to
<u>Rt. 4</u> <u>Coldwater</u> (mailing address)			
	<u>top soil</u>	<u>0</u>	<u>15</u>
	<u>red sand & clay</u>	<u>15</u>	<u>40</u>
	<u>sand & clay</u>	<u>40</u>	<u>100</u>
	<u>coarse sand</u>	<u>100</u>	<u>115</u>

WELL LOCATION:
sec 29 T 4 N R 5 E
4 1/2 miles E of Independence
(distance) (direction) (nearest town)

WELL PURPOSE: none
(home, irrigation, municipal, industrial)

- WELL COMPLETION DATA:
- (1) diameter (inches) 4
 - (2) total depth (feet) 115
 - (3) static water level (feet) 80 ^{below} ~~above~~ top of ground.
 - (4) casing Plastic, 108,
(material) (depth)
4
(size) if telescope see back.
 - (5) screen 7, 108
(length) (depth to top)
008, Plastic
(size) (material)
 - (6) pump 3/4, 97
(HP) (yield gpm)
elec.
(type power)
 - (7) electric log no
(yes or no)
- (organization running log)
- (8) how well bottom plugged solid


CODED

RECORDED
FEB 22 1974

DRILLERS REMARKS:

If well telescopes please sketch and show depths.

GROUND LEVEL

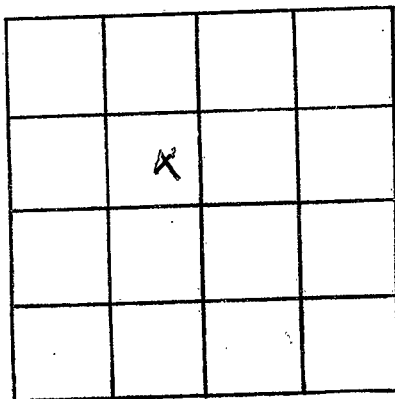

SECTION 29

Please indicate well location X.

ADDITIONAL INFORMATION

If more than one screen, show locations of each on sketch.