

LATE
D 64
12-15-73

MISSISSIPPI
BOARD OF WATER COMMISSIONERS
416 North State Street
Jackson, Mississippi 39201

CODED

WATER WELL DRILLERS LOG

12-15 1973 Harris Bros. Late
date well completed firm name county well located

LANDOWNER: J. R. Arnet
Rt. 4
Cold water
(mailing address)

description of formations encountered	from	to
top soil	0	15
red sand & clay	15	40
sand & clay	40	100
dense coarse sand	100	115

WELL LOCATION:
sec 29 T 4 N R 5 E
4 1/2 miles E of Independence
(distance) (direction) (nearest town)

WELL PURPOSE: home
(home, irrigation, municipal, industrial)

- WELL COMPLETION DATA:
- (1) diameter (inches) 4
 - (2) total depth (feet) 115
 - (3) static water level (feet) 80 ^{below} top of ground
 - (4) casing Plastic 108 (material) (depth)
4 (size) if telescope see back.
 - (5) screen 7 (length) 108 (depth to top)
008 (size) plastic (material)
 - (6) pump 3/4 (HP) 7 (yield gpm)
elec (type power)
 - (7) electric log no (yes or no)
 - (8) how well bottom plugged solid

CODED


RECEIVED
FEB 26 1974

DRILLERS REMARKS:

MISS. RD OF WATER COMM

If well telescopes please sketch and show depths.

GROUND LEVEL

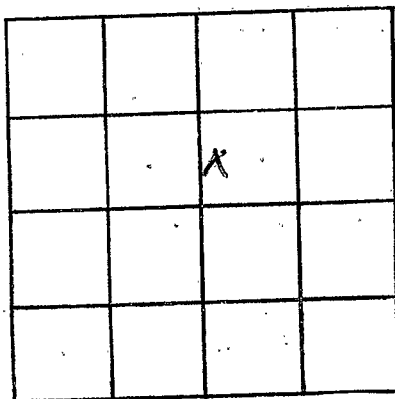

SECTION _____

Please indicate well location X.

ADDITIONAL INFORMATION

If more than one screen, show locations of each on sketch.