

TATE

MARSHALL

D 65

3/74

MISSISSIPPI
 BOARD OF WATER COMMISSIONERS
 416 North State Street
 Jackson, Mississippi 39201

CODED

WATER WELL DRILLERS LOG

TATE

A. K. Kison & Frost

MARSHALL

date well completed

firm name

county well located

LANDOWNER:

Tracy, Foson
 Rt 3 Box 214
 Byhalia, MISS.
 (mailing address)

description of formations encountered

from

to

Red Clay	0	15
Red Sand	15	50
White Clay	50	80
White sand	80	120

WELL LOCATION:

sec. 4 T 4 N R 5 E
 (S) (W)
1/2 miles South East of Watson
 (distance) (direction) (nearest town)

WELL PURPOSE:

(home, irrigation, municipal, industrial)

WELL COMPLETION DATA:

- (1) diameter (inches) 4 1/2
- (2) total depth (feet) 120
- (3) static water level (feet) 90 below top of ground.
- (4) casing 1 1/2 (material) " (depth)
 (size) if telescope see back.
- (5) screen 1 1/2 (length) " 120 (depth to top)
 (size) (material)
- (6) pump 3/4 (HP) " 10 (yield gpm)
Floc (type power)
- (7) electric log (yes or no)

(organization running log)

(8) how well bottom plugged

DRILLERS REMARKS:

CODED


DISCOVER INVESTMENT

FEB 27 1974

MISS. BD. OF WATER COMMISSIONERS

If well telescopes please sketch and show depths.

GROUND LEVEL

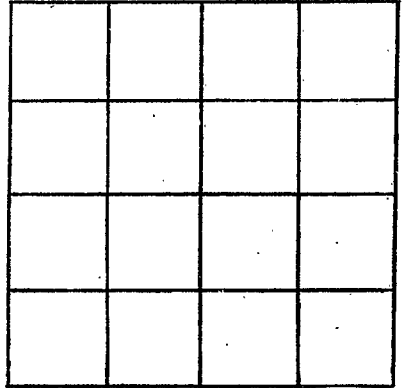

SECTION _____

Please indicate well location X.

ADDITIONAL INFORMATION

A series of horizontal lines for entering additional information.

If more than one screen, show locations of each on sketch.