

TATE
D66
3-29-74

MISSISSIPPI
BOARD OF WATER COMMISSIONERS
416 North State Street
Jackson, Mississippi 39201

WATER WELL DRILLERS LOG CODED

3-29 1974 Bluffs Land, LLC State
date well completed firm name county well located

LANDOWNER:
James Rogers - Pt 4
Adrienne, Mrs.
(mailing address)

description of formations encountered	from	to
<u>Red Clay</u>	<u>0</u>	<u>15</u>
<u>Red Sand</u>	<u>15</u>	<u>45</u>
<u>white</u>	<u>45</u>	<u>113</u>

WELL LOCATION:
sec 15 T 4 N R 5 E
3 miles NW of Roll Hill
(distance) (direction) (nearest town)

WELL PURPOSE: Home
(home, irrigation, municipal, industrial)

WELL COMPLETION DATA:

- (1) diameter (inches) 4 1/2"
- (2) total depth (feet) 113
- (3) static water level (feet) 70 below top of ground.
- (4) casing Plastic, 113,
(material) (depth)
____ (size) if telescope see back.
- (5) screen 4ft, 109
(length) (depth to top)
4 1/2" Screen
(size) (material)
- (6) pump 1/2, 100
(HP) (yield gpm)
Electric 110
(type power)
- (7) electric log no
(yes or no)
- ____ (organization running log)
- (8) how well bottom plugged cap


CODED

DRILLERS REMARKS:

RECORDED
INDEXED
MAY 21 1974
MISSISSIPPI BOARD OF WATER COMMISSIONERS

If well telescopes please sketch and show depths.

GROUND LEVEL

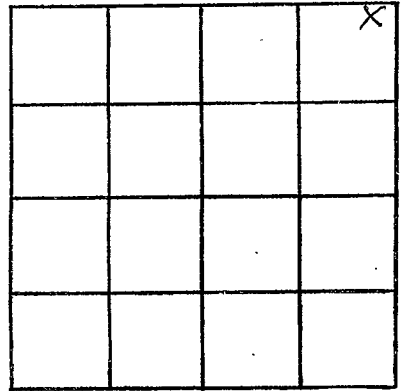

SECTION 15

Please indicate well location X.

ADDITIONAL INFORMATION

If more than one screen,
show locations of each on sketch.