

TATE
D 67
8-12-74

MISSISSIPPI
BOARD OF WATER COMMISSIONERS
416 North State Street
Jackson, Mississippi 39201

CODED

WATER WELL DRILLERS LOG

8-12-74 date well completed
74 Hubs Bore Well Co. firm name
Tate county well located

LANDOWNER: Northwest
Miss. Childcare Center
P.O. 2, Coldwater, Miss.
(mailing address)


description of formations encountered	depth	
	from	to
Red Clay	0	15
white sand	15	60
white sand & gravel	60	90
white sand	90	130

WELL LOCATION:
sec 33 T 4 N R 5 E
1 miles NE of Bet
(distance) (direction) (nearest town)

WELL PURPOSE: Home
(home, irrigation, municipal, industrial)

WELL COMPLETION DATA:

(1) diameter (inches) 4 in.
(2) total depth (feet) 130
(3) static water level (feet) 70 below top of ground.
(4) casing Elastic, 130, (material) (depth)
If telescope see back.
(5) screen 8 ft, 182 (length) (depth to top)
4 in, Gravel (size) (material)
(6) pump 1 1/2 (HP) 10 (yield gpm)
Electric 220 (type power)
(7) electric log 400 (yes or no)
(organization running log)
(8) how well bottom plugged Cap

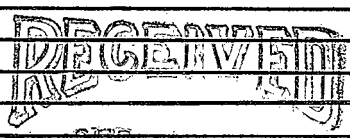

SEP 25 1974

DRILLERS REMARKS:

If well telescopes please sketch and show depths.

GROUND LEVEL

			X

SECTION 33

Please indicate well location X.

ADDITIONAL INFORMATION

If more than one screen,
show locations of each on sketch.