

TATE
D 68
8-9-74

MISSISSIPPI
BOARD OF WATER COMMISSIONERS
416 North State Street
Jackson, Mississippi 39201

CODED

WATER WELL DRILLERS LOG

8-9-74 date well completed
74 Hicks Blvd. N. W. La. firm name
La. county well located

LANDOWNER:

Mina Farrow -
Under residence, Miss
(mailing address)

description of formations encountered

from to

Red Clay	0	30
Red Clay & Sand	30	45
White Sand	45	60
White Sand & Gravel	60	90
White Sand	90	140

WELL LOCATION:

sec 30 T 4 N R 5 E
34 miles N of Pet
(distance) (direction) (nearest town)

WELL PURPOSE:

Home
(home, irrigation, municipal, industrial)

WELL COMPLETION DATA:

- (1) diameter (inches) 4 1/2
- (2) total depth (feet) 140
- (3) static water level (feet) 45 below top of ground.
- (4) casing Plastic, 140
(material) (depth)
- (5) screen 4 ft, 136
(length) (depth to top)
4 in. Gravel
(size) (material)
- (6) pump 1/2, 10
(HP) (yield gpm)
Electric 220
(type power)
- (7) electric log No
(yes or no)

(organization running log)


(8) how well bottom plugged Cap

RECEIVED
SEP 25 1974

DRILLERS REMARKS:

If well telescopes please
sketch and show depths.

GROUND LEVEL

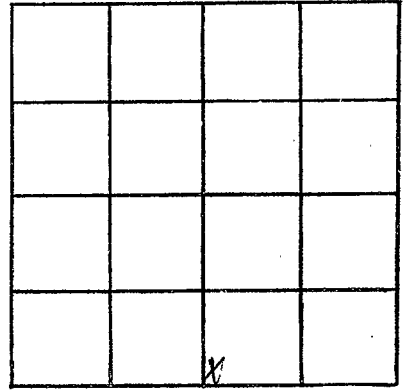

SECTION 30

Please indicate well location X.

ADDITIONAL INFORMATION

If more than one screen,
show locations of each on sketch.