

TATE  
D 70  
7/5/74

MISSISSIPPI  
 BOARD OF WATER COMMISSIONERS  
 416 North State Street  
 Jackson, Mississippi 39201

WATER WELL DRILLERS LOG

CODED

7-5 1974 Harris Bros. Tate  
 date well completed firm name county well located

LANDOWNER: Bob Pope  
Rt. 3  
Caldwater  
 (mailing address)

description of formations encountered	from	to
<u>top soil</u>	<u>0</u>	<u>20</u>
<u>red sand</u>	<u>20</u>	<u>45</u>
<u>clay</u>	<u>45</u>	<u>120</u>
<u>clay &amp; sand</u>	<u>120</u>	<u>140</u>
<u>coarse sand</u>	<u>140</u>	<u>160</u>

WELL LOCATION:  
 sec. 28 T 4 N R 5 E  
3 miles NW of Bett  
 (distance) (direction) (nearest town)

WELL PURPOSE: none  
 (home, irrigation, municipal, industrial)

- WELL COMPLETION DATA:
- (1) diameter (inches) 4
  - (2) total depth (feet) 160
  - (3) static water level (feet) 80 below above top of ground.
  - (4) casing Plastic, 146  
 (material) (depth)  
4 if telescope see back.  
 (size)
  - (5) screen 14, 146  
 (length) (depth to top)  
009, Plastic  
 (size) (material)
  - (6) pump 3/4, 7  
 (HP) (yield gpm)  
elec.  
 (type power)
  - (7) electric log no  
 (yes or no)
- (organization running log)
- (8) how well bottom plugged solid


CODED

DRILLERS REMARKS:

RECEIVED  
 OCT 15 1974

If well telescopes please sketch and show depths.

GROUND LEVEL

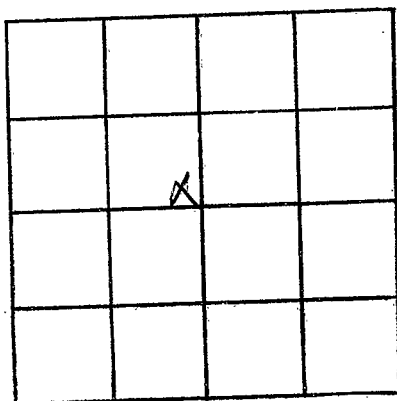

SECTION 28

Please indicate well location X.

ADDITIONAL INFORMATION

If more than one screen,  
show locations of each on sketch.