

TATE
D 71
5-19-75

MISSISSIPPI
BOARD OF WATER COMMISSIONERS
416 North State Street
Jackson, Mississippi 39201

CODED

WATER WELL DRILLERS LOG

5-19-1975 date well completed
Shicks Well Co. firm name
Tate county well located


LANDOWNER: Whitt Thurston
Route 4 Box 283,
Coldwater, Miss.
(mailing address)

description of formations encountered	from	to
Red Clay	0	30
Red sand + Gravel	30	45
White sand + Red clay	45	60
white sand + gravel	60	75
white sand	75	150

WELL LOCATION:
sec. 17 T. 4 N. R. 5 E
4 miles NE of Set
(distance) (direction) (nearest town)

WELL PURPOSE:
(home, irrigation, municipal, industrial)

- WELL COMPLETION DATA:
- (1) diameter (inches) 4 1/2 in.
 - (2) total depth (feet) 150
 - (3) static water level (feet) 100 below above top of ground.
 - (4) casing Plastic, 150,
(material) (depth)
 - (size) if telescope see back.
 - (5) screen 4 ft, 140
(length) (depth to top)
 - 4 1/2, Gravel
(size) (material)
 - (6) pump 1/2, 10
(HP) (yield gpm)
 - Electric, 230
(type power)
 - (7) electric log no
(yes or no)
 - (organization running log)
 - (8) how well bottom plugged Cap

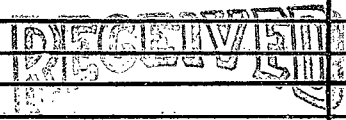

DRILLERS REMARKS:

MAY 23 1975

If well telescopes please sketch and show depths.

GROUND LEVEL

			X

SECTION 17

Please indicate well location X.

ADDITIONAL INFORMATION

If more than one screen, show locations of each on sketch.