

MISSISSIPPI DEPARTMENT OF ENVIRONMENTAL QUALITY

Office of Land and Water Resources

P. O. Box 10631
Jackson, MS 39289-0631
WATER WELL DRILLERS LOG

COUNTY WELL LOCATED
ITW

WELL NUMBER: D-92 CODED

DATE WELL COMPLETED: 9-19-03

PERMIT NUMBER

NAME OF DRILLING FIRM
R. M. S. WELL DR.

KELANFOR L

NAME & MAILING ADDRESS OF LANDOWNER
Therman
No 911 vet

Lat #1 Betty meadow road
Colowater

Latitude:
Longitude: 28

WELL LOCATION: SEC TOWNSHIP RANGE
28 N 5 EW

DISTANCE DIRECTION NEAREST TOWN
1 Miles S of WALWILL

OTHER LANDMARK

WELL PURPOSE: Home, Irrigation, Municipal, Industrial, Fish Pond, etc.
Home

PUMP DATA

PUMP TYPE (Circle One):
Submersible (checked) Turbine Jet Flowing Well,
Other (Describe)

POWER TYPE (Circle One):
Electric (checked) Tractor Diesel Gasoline Butane,
Other (Describe) H/P 34

DESCRIPTION OF FORMATIONS ENCOUNTERED	FROM	TO
<u>NET</u>	<u>0</u>	<u>20</u>
<u>SAND</u>	<u>20</u>	<u>60</u>
<u>CRAY CLAY</u>	<u>60</u>	<u>140</u>
<u>SAND</u>	<u>140</u>	<u>200</u>

RECEIVED
SEP 21 2003
BY: OLWR

Top of Lap Pipe or Reduction in Casing

FEET IF TELESCOPED OR MORE THAN ONE SCREEN: USE BACK PAGE

WELL DATA

Well Depth <u>200</u>	Casing Diameter (In.) <u>4</u>	Casing Length (Ft.) <u>20</u>
Type of Casing <u>PVC</u>	Hole Depth <u>200</u>	Depth to Static Water Level <u>95'</u>

TYPE OF COMPLETION: (Circle One or More):
Gravel Packed (checked) Underreamed Telescoped,
Natural Development, Open Hole, Other
(Describe)

WELL GROUTED TO A DEPTH OF 10 FEET
Type Grout (circle one): Cement, Bentonite, or Mix

SCREEN DATA

Diameter - Inches <u>4</u>	Length - Feet <u>10</u>	Slot Size - Inches <u>.013</u>
Screen Type <u>Slot PVC</u>	Depth to Bottom - Feet <u>200</u>	

I certify that the well was drilled, constructed and completed in accordance with all applicable Requirements of the Mississippi Department of Environmental Quality and/or the Mississippi Department of Health regulations and state laws.


Frank Langford
Signature of Licensed Driller and License No. 0-622

9-17-03
Date

Additional Information Required On Back

If well telescopes please sketch and show depths.

GROUND LEVEL

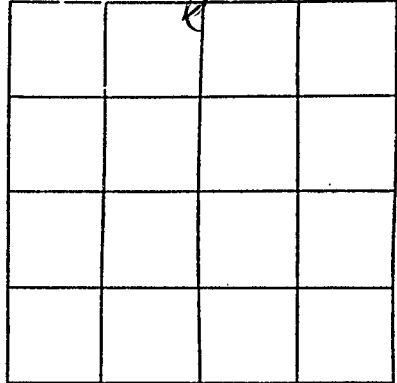

SECTION 28

Please indicate well location X.

Pump Capacity (GPM)	No. of Stages	Setting Depth	
<u>12</u>	<u>12</u>	<u>140</u>	FT.
PUMP TEST			
Well yielded <u>125</u> GPM with			
a drawdown of <u>3</u> ft.			
after _____ hours of pumping			

LOG DATA

TYPE OF LOG RUN (Circle One): No Log Run
Electric, Gamma Ray, Density, Sonic, Neutron,
Other (Describe) _____

Name of Organization Running Log _____

GEOLOGIC DATA (Office Use Only)

Surface Elev.	Geologic Unit	Unit Thickness	Depth to Top
Subs. SWL	Date	Analysis	Aquifer Test

Driller's Remarks

If more than one screen, show location of each on sketch.