	State Well Report	
County: TATA	Part 1 – Driller's Log	For Office Use Only:
Permit #:	Mississippi Department of Environmental Quality Office of Land and Water Resources	Aquifer:
Driller: F= LARGFORE	P.O. Box 10631	Well #:34
Date drilling completed: 6.119-07	Jackson, MS 39289-0631 (601)961-5210	L. S. Elevation:
	(601)354-6938 (fax)	E-log #:


٠, •

٩¢

State Law requires that this report be prepared by the license holder responsible for the work and filed with the Department at the above address within 30 days of completion of drilling of the well or borehole.

well Information on Well Owner	pleasen of aruting of the well or borehole.		
$\# \mathcal{L}$ (Landowner if borehole is not for a water well)	Well or Borehole Location		
Owner Name Greg FARROW	Latitude:' Longitude:' "		
Mailing Address: BeTTRK	Method of Lat/Long (circle one): Conventional Survey,		
	USGS quad, Hand-held GPS, Survey-grade GPS		
Celdust Ter m5 City State Zip Code	<u>4 4 Sec_32 Twn 4 5 Rng_5 w</u>		
	Distance Direction Nearest Town <u><u>J</u> Miles <u>ii</u> of <u>Independence</u></u>		
Telephone No. ()			
Weil / Bore	hole Data		
Date drilling started: 6.19 Date drilling completed: 6.2	Hole depth: 180 Hole diameter: $6\frac{2}{5}$		
Location of the source of any surface water used for drilling:			
Logs run (circle all applicable): No log run Electric Gamma Ray Name of organization running log(s): (Attach copy of log to this report)	Density Sonic Neutron Other:		
Purpose of borehole (check one): Water Well X Geotechnical/Geolo Seismic Survey Other (describe) If drilling is not related to water well construction	, skip the remainder of this block		
Purpose of Well (check one): Home Industrial Public Supply	IrrigationFish CultureOther:		
If a flowing well, method of flow regulation: Valve Ot			
Static Water Level: <u>50</u> feet above or below (circle one) la			
Method of Measurement (circle one) steel tape electric tape			
Well depth: <u>150</u> Well grouted to a depth of <u>10</u> feet Type of			
Casing length: <u>20</u> feet Casing diameter: <u>-</u>	inches Type of casing: <u>nuc</u>		
Screen length: 10 feet Screen diameter:	inches Type of screen: 510Tre 1942		
	120 feet to 180 feet		
ype of completion (circle all applicable): Gravel packed Underre			
Other (describe):			
op of lap pipe or reduction in casing: <u><i>ROUL</i></u> feet. <u>If tele</u>	scoped or more than one screen, describe on next page		
	RECEIVF		

JUL 0 9 2007 BY: OLWR

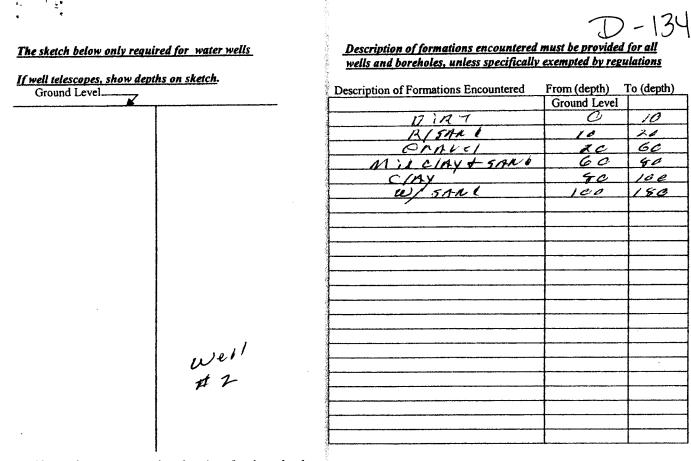

If more than one screen, show location of each on sketch

Sketch the property layout and include the following: 1) the well location; 2) any permanent structures on the property that may					
aid in locating the well; 3) any roads, power lines, or other items that may aid in locating the property and the well;					
aid in locating the well; 3) any roads, power lines, or other items that may aid in locating the property and the well; 4) a north arrow. IHTEMPRShAll Control Well # H					
THE ALLER					
Buen					
well totat					
ŦŒ₽					
in well					
Pet I					
Landowner Name: <u>Creg FARRow</u>					

I certify that the well/borehole was drilled, constructed, and completed in accordance with all applicable requirements of the Mississippi Department of Environmental Quality and the Mississippi Department of Health regulations, if applicable, and state

 Iaws.
 U-GAZ
 RECEIVED

 FVMAK K Mag ford
 6-21-07
 Leantr Lang ford

 Print Name of Responsible Licensee and License No.
 Date
 Signature of Licensee

BY: OLWR

		ELL REPORT		
County: TH-TE		Part 2	For Office Use Only:	
Permit #:	Pump Installer's Completion Report Mississippi Department of Environmental Quality			
	Office of Land and Water Resources		Aquifer:	
Driller: <u>FLM NG FOR &</u> Date completed: <u>6-00-07</u>	1	Box 10631	Well #:3L	
Date completed: 6-69-07	1	MS 39289-0631 1)961-5210	-	
Copy information from block on Part 1	(601)354-6938 (fax)		Elevation:	
This part of the report must be completed report must be attached and both parts fil] by a licensed water well led with the Department	l contractor or a licensed pump i at the above address within 30 a	installer. A copy of Part 1 of the lays of well completion.	
Well that Well Owner Informat	tion	We	Il Location	
Well w owner Name: <u>Creq I=MRROw</u>		Latitude:	Latitude: Longitude:	
Mailing Address: <u>BETT Rd</u>		Method of Lat/Long (check one): Conventional Survey,		
		USGS quad, Hand-held GPS, Survey-grade GPS		
CPI WATER MS City State Zip Code		1/4 1/4 Sec_ 3	<u>4 4 Sec 32 T 4 9 R 50</u>	
City State	Zip Code	Distance Direction	Nearest Town	
Telephone No. ()	· · · · · · · · · · · · · · · · · · ·	<u></u> Miles <u></u>	of Independence	
Ритр Туре		Pa	wer Type	
Circle one		C	Circle one	
Air Lift Jet	Submersible	Diesel Engine Gasoli	ne Engine Natural Gas	
Bucket Piston	Turbine	Electric Motor Hand	Tractor PTO	
Centrifugal Rotary	Flowing Well		(specify):	
Other (specify):		Horse Power Rating of Motor	r. <u>34</u>	
Date Pump Installed: 6-18-0	· 7	Setting Depth:	<u>C</u> feet	
Rated Pump Capacity:	_Gallons Per Minute	Number of Stages:		
Pump Test Data			easuring Water Level	
Date Well Tested: 6-18-07	7		asuring Line Steel Tape	
Static Water Level (A): <u><u>50</u> Feet Below Land Surface</u>		Other (specify):		
Pumping Water Level (B): <u>50</u> Feet	t Below Land Surface			
Drawdown [(B) – (A)]:Fee	t Below Land Surface		shut in head:feet	
Test Pumping Rate: 19 + Gallons Per Minute			GPM with a drawdown of	
	i): <u> </u>	fact offer	hours of pumping	

EWANK	LARG	FORL	0-622
Print Name of Pur	no Installer	and License 1	No. (if applicable)

6 - 5 6 - 6

Signature of Pump Installer JUL 0 9 2007 BY: OLWR