

State Well Report

Part 1 - Driller's Log

Mississippi Department of Environmental Quality
 Office of Land and Water Resources
 P.O. Box 10631
 Jackson, MS 39289-0631
 (601)961-5210
 (601)354-6938 (fax)

County: TATT
 Permit #: _____
 Driller: F L Haggford
 Date drilling completed: 6-18-07

For Office Use Only:
 Aquifer: _____
 Well #: D-135
 L. S. Elevation: _____
 E-log #: _____

State Law requires that this report be prepared by the license holder responsible for the work and filed with the Department at the above address within 30 days of completion of drilling of the well or borehole.

Information on Well Owner (Landowner if borehole is not for a water well)	Well or Borehole Location
Owner Name: <u>Greg Farrow</u>	Latitude: _____ Longitude: _____
Mailing Address: <u>BETTER</u>	Method of Lat/Long (circle one): Conventional Survey, USGS quad, Hand-held GPS, Survey-grade GPS
<u>COLDWATER MS</u> City State Zip Code	<u>1/4 1/4 Sec 32 Twn 4 S Rng 5 W</u>
Telephone No. () _____	Distance Direction Nearest Town <u>3 Miles W of Independence</u>

Well / Borehole Data

Date drilling started: 6-18 Date drilling completed: 6-18 Hole depth: 180 Hole diameter: 6 7/8

Location of the source of any surface water used for drilling: same well

Method of dosing and volume of Chlorine used in drilling and development: 2 GAL CLOROX

Logs run (circle all applicable): No log run Electric Gamma Ray Density Sonic Neutron Other: _____

Name of organization running log(s): _____
 (Attach copy of log to this report)

Purpose of borehole (check one): Water Well Geotechnical/Geological Investigation _____ Ground Source Heat Pump _____
 Seismic Survey _____ Other (describe) _____

If drilling is not related to water well construction, skip the remainder of this block

Purpose of Well (check one): Home Industrial _____ Public Supply _____ Irrigation _____ Fish Culture _____ Other: _____

If a flowing well, method of flow regulation: Valve _____ Other (describe) _____

Static Water Level: 50 feet above or below (circle one) land surface Date measured: 6-18-07

Method of Measurement (circle one) steel tape electric tape air line other: _____

Well depth: 180 Well grouted to a depth of 10 feet Type of grout (circle one): Neat Cement Bentonite Mix

Casing length: 20 feet Casing diameter: 4 inches Type of casing: PVC

Screen length: 10 feet Screen diameter: 4 1/2 inches Type of screen: 510T & 10VC

Screen slot size: 0.13 inches Setting depth: From 170 feet to 180 feet

Type of completion (circle all applicable): Gravel packed Underreamed Telescoped Open hole Natural Development
 Other (describe): _____

Top of lap pipe or reduction in casing: none feet. **If telescoped or more than one screen, describe on next page.**

RECEIVED
 JUL 09 2007
 BY: OLWR

D-135

The sketch below only required for water wells

If well telescopes, show depths on sketch.


Ground Level $\xrightarrow{\quad}$

Description of formations encountered must be provided for all wells and boreholes, unless specifically exempted by regulations

Description of Formations Encountered	From (depth)	To (depth)
	Ground Level	
DIRT	0	10
R/SAND	10	20
GRAVEL	20	60
MID CLAY + SAND	60	90
CLAY	90	100
W/SAND	100	180

If more than one screen, show location of each on sketch

Sketch the property layout and include the following: 1) the well location; 2) any permanent structures on the property that may aid in locating the well; 3) any roads, power lines, or other items that may aid in locating the property and the well; 4) a north arrow.

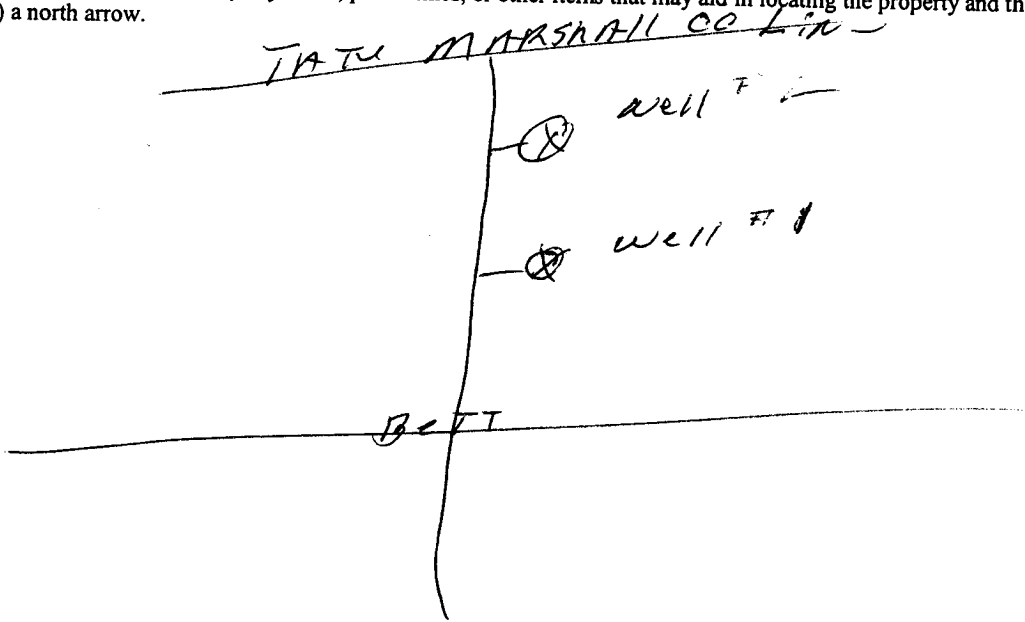

Landowner Name: Creg FARROW

I certify that the well/borehole was drilled, constructed, and completed in accordance with all applicable requirements of the Mississippi Department of Environmental Quality and the Mississippi Department of Health regulations, if applicable and state laws.

Print Name of Responsible Licensee and License No. FRANK LANGFORD

Date 6-18-07

Signature of Licensee Frank Langford

RECEIVED

JUL 09 2007

BY: OLWR

STATE WELL REPORT

Part 2

Pump Installer's Completion Report
 Mississippi Department of Environmental Quality
 Office of Land and Water Resources
 P.O. Box 10631
 Jackson, MS 39289-0631
 (601)961-5210
 (601)354-6938 (fax)

County: TATE
 Permit #: _____
 Driller: FRANK FORK
 Date completed: 6-18-07
Copy information from block on Part 1

For Office Use Only:

Aquifer: _____
 Well #: D-135
 Elevation: _____

This part of the report must be completed by a licensed water well contractor or a licensed pump installer. A copy of Part 1 of the report must be attached and both parts filed with the Department at the above address within 30 days of well completion.

Well Owner Information	Well Location
Owner Name: <u>Greg FARROW</u>	Latitude: _____ Longitude: _____
Mailing Address: <u>BETT RD</u>	Method of Lat/Long (check one): Conventional Survey _____
<u>COLE WATER MS</u>	USGS quad _____, Hand-held GPS _____, Survey-grade GPS _____
City State Zip Code	_____ 1/4 _____ 1/4 Sec <u>32 T 49 R 5W</u>
Telephone No. () _____	Distance Direction Nearest Town
	<u>3</u> Miles <u>W</u> of <u>INDEPENDENCE</u>

Pump Type Circle one	Power Type Circle one
Air Lift Jet <u>Submersible</u>	Diesel Engine Gasoline Engine Natural Gas
Bucket Piston Turbine	<u>Electric Motor</u> Hand Tractor PTO
Centrifugal Rotary Flowing Well	Windmill Other (specify): _____
Other (specify): _____	Horse Power Rating of Motor: <u>3/4</u>
Date Pump Installed: <u>6-18-07</u>	Setting Depth: <u>120</u> feet
Rated Pump Capacity: <u>12</u> Gallons Per Minute	Number of Stages: <u>12</u>

Pump Test Data	Method of Measuring Water Level Circle one
Date Well Tested: <u>6-18-07</u>	Air Line Electric Measuring Line <u>Steel Tape</u>
Static Water Level (A): <u>50</u> Feet Below Land Surface	Other (specify): _____
Pumping Water Level (B): <u>50</u> Feet Below Land Surface	For flowing well, measured shut in head: _____ feet
Drawdown [(B) - (A)]: <u>0</u> Feet Below Land Surface	Well yielded <u>15+</u> GPM with a drawdown of
Test Pumping Rate: <u>15+</u> Gallons Per Minute	<u>0</u> feet after <u>4</u> hours of pumping
Duration of Pump Test (minimum 4 hours): <u>4</u> hours	

I HEREBY CERTIFY that the above statements are true to the best of my knowledge.

FRANK FORK 0-622 Frank Langford
 Print Name of Pump Installer and License No. (if applicable) Signature of Pump Installer

RECEIVED
 JUL 09 2007
 BY: OLWR