State Well Report			
	1	For Office Use Only:	
County: Ge	Part 1 – Driller's Log	For Office Use Only.	
	Mississippi Department of Environmental Quality	Aquifer:	
Permit #:	Office of Land and Water Resources	well #: D-139	
Driller: Jore, w. Mason	P.O. Box 10631	well #:	
	Jackson, MS 39289-0631	L. S. Elevation:	
Date drilling completed: <u>7 - う 5 - じ う</u>	(601)961-5210		
	(601)354-6938 (fax)	E-log #:	

State Law requires that this report be prepared by the license holder responsible for the work and filed with the Department at the above address within 30 days of completion of drilling of the well or borehole.

Information on Well Owner	Well or Borehole Location		
(Landowner if borehole is not for a water well)	Latitude: 34 .44 ,290, Longitude: 89.44, 413,		
Owner Name Jo Austin	Method of Lat/Long (circle one): Conventional Survey,		
Mailing Address: May 30 (a)			
LOT # 28	USGS quad Hand-held GPS Survey-grade GPS		
• • • • • • • • • • • • • • • • • • • •	NW 1/5W 1/2 Sec_ 6 Twn 45 Rng 5W		
<u>colductor</u> MS <u>38618</u> City State Zip Code	Distance Direction Nearest Town		
	Distance Direction Nearest Town <u>12</u> Miles <u>5</u> of <u>wore feild</u>		
Telephone No. (66) 292-1551			
Well / Bore	hole Data		
Date drilling started: $\underline{7-35-07}$ Date drilling completed: $\underline{7-35-07}$	0) Hole denth: 140' Hole digmeter: 63/4		
•			
Location of the source of any surface water used for drilling:			
Method of dosing and volume of Chlorine used in drilling and devel	opment: <u>M</u>		
Logs run (circle all applicable): No log run) Electric Gamma Ray Density Sonic Neutron Other:			
Purpose of borehole (check one): Water Well 🖌 Geotechnical/Geol	ogical Investigation Ground Source Heat Pump		
Seismic Survey Other ( <i>describe</i>	2)		
If drilling is not related to water well construction	n, skip the remainder of this block		
Purpose of Well (check one): Home <u>Industrial</u> Public Supply	y Irrigation Fish Culture Other:		
If a flowing well, method of flow regulation: Valve $\longrightarrow$ C	Other (describe)		
Static Water Level: <u>95</u> feet above grobelow (dircle one)	land surface Date measured: フーンに いつ		
Method of Measurement (circle one) steel tape electric tape	air line other: <u>string lueisut</u>		
Well depth: $(40)$ Well grouted to a depth of $10$ feet Type of grout (circle one): Neat Cemer Bentonite Mix			
Casing length: 130 feet Casing diameter: 4 inches Type of casing:			
Screen length: $(\circ)$ feet Screen diameter: $(\circ)$ inches Type of screen: $(\circ)$ $(\circ)$			
Screen slot size: <u>. O(O</u> inches Setting depth: From <u>130</u> feet to <u>140</u> feet			
Type of completion (circle all applicable). Gravel packed Underreamed Telescoped Open hole Natural Development			
Other (describe):			
Top of lap pipe or reduction in casing:feet. <u>If te</u>	elescoped or more than one screen, describe on next page		
	Form: OLWR-SWR-1A		

AUG 25 2000 BY: OLW P

## The sketch below only required for water wells


If well telescopes,	show	depths	on	sketch.
Ground Level.		7		

	Description of Fon
······	Cley
	white
	it it
	ushite ushite the

Description of formations encountered must be provided for all wells and boreholes, unless specifically exempted by regulations

Description of Formations Encountered	From (depth)	To (depth)
Cley dirt	Ground Level	35
white sand	35	115
white day	115	122
white soud	199	140
······		
		·
		·
· · · · · · · · · · · · · · · · · · ·		L
		<b>├</b>
		ll
		L

If more than one screen, show location of each on sketch

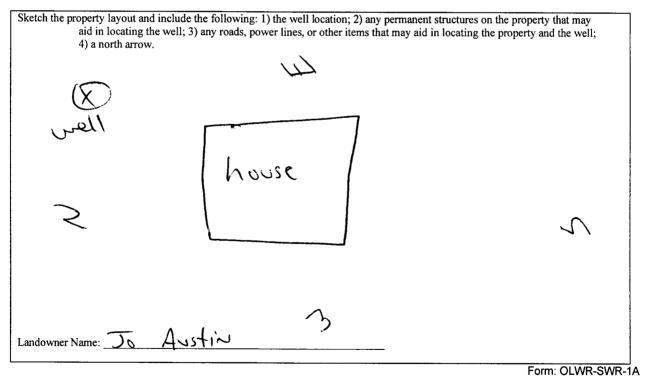

I certify that the well/borehole was drilled, constructed, and completed in accordance with all applicable requirements of the Mississippi Department of Environmental Quality and the Mississippi Department of Health regulations, if applicable, and state

laws. Jones UN Mason 0-620 8-20-07 Date

Signature of Licensee RECEIVED

Print Name of Responsible Licensee and License No.

AUG 2 9 2007 BY: OLWB

STATE WELL REPORT			
County: Tote	Part 2 Pump Installer's Completion Report	For Office Use Only:	
Permit #:	Mississippi Department of Environmental Quality	Aquifer:	
Driller: Jones W. Masu	Office of Land and Water Resources P.O. Box 10631	D-129	
Date completed: $7 - 26 - 37$	Jackson, MS 39289-0631 (601)961-5210	Well #: <u>D-139</u>	
Copy information from block on Part 1	(601)354-6938 (fax)	Elevation:	
	1		

This part of the report must be completed by a licensed water well contractor or a licensed pump installer. A copy of Part 1 of the report must be attached and both parts filed with the Department at the above address within 30 days of well completion.

Well Owner Information	Well Location		
Owner Name: Jo Austin	Latitude: 34-44. 290 Longitude: 89, 44. 413		
$\begin{array}{c} \text{Mailing Address:} & MAY \times \mathcal{C} \\ \hline \\ $	Method of Lat/Long (check one): Conventional Survey, USGS quad, Hand-held GPS $ ull,$ Survey-grade GPS		
( <u>elduster</u> M) <u>38618</u> City State Zip Code	$N^{1} M^{1} M^{1} M^{1} M^{1} Sec_{1}^{1} M^{1} M^{1$		
City State Zip Code	Distance Direction Nearest Town		
Telephone No. 6622921551	12 Miles 5 of workefeild		
Pump Type Circle one	Power Type Circle one		
Air Lift Jet Submersible	Diesel Engine Gasoline Engine Natural Gas		
Bucket Piston Turbine	Electric Motor Hand Tractor PTO		
Centrifugal Rotary Flowing Well	Windmill   Other (specify):		
Other (specify):	Horse Power Rating of Motor: <u>3/4</u>		
	Setting Depth:feet		
Rated Pump Capacity:Gallons Per Minute	Number of Stages:		
Pump Test Data	Method of Measuring Water Level		

Pump Test Data	Method of Measuring Water Level Circle one	
Date Well Tested: 7-26-07		
Static Water Level (A):Feet Below Land Surface	Air Line Electric Measuring Line Steel Tape Other (specify): <u>5tring (neight</u>	
Pumping Water Level (B): Feet Below Land Surface	Omer (specify):	
Drawdown [(B) – (A)]: Feet Below Land Surface	For flowing well, measured shut in head:feet	
Test Pumping Rate: 13 Gallons Per Minute	Well yielded ( $\lambda$ GPM with a drawdown of	
Duration of Pump Test (minimum 4 hours): $\underline{\neg \neg}$ hours	- feet after $24$ hours of pumping	

I HEREBY CERTIFY that the above statements are true to the best of	f my knowledge.	
Jas w. Mason 0-620	Gens w mon	
Print Name of Pump Installer and License No. (if applicable)	Signature of Pump Installer	
		Form: OLWR-SWR-1B

ANG 2 9 2007 BY: OLWR