	State W	ell Report	·····		
County: Tate		Driller's Log	For Office Use Only:		
Permit #:	Mississippi Departmei Office of Land a	nt of Environmental Quality nd Water Resources	Aquifer:		
Driller: Jones W. Mason	P.O.	Box 2309	well #: D- 150		
Date drilling completed: 9-11-68	(601)	n, <b>MS</b> 39225 961- 5210	L. S. Elevation:		
	(601)96	1- 5228 (fax)	E-log #:		
State Law requires that this report be prepared by the license holder responsible for the work and filed with the Department at the above address within 30 days of completion of drilling of the well or borehole.					
Information on Well Owner Well or Borehole Location					
(Landowner if borehole is not fo		Latitude: 34 . 44 . 530	), Longitude: 89 . 44, 994		
Owner Name Micheel Byc			D' Longitude: 89 ° 44, 994, 45 60		
Mailing Address: wokefe	ild rd				
Mailing Address: wothere double red me No odress cuolis	te- drewy	USGS quad, $\underbrace{\text{Hand-held GPS}}_{\text{SE} \ \ \ \ \ \ \ \ \ \ \ \ \ \ \ \ \ \ \$			
City State					
City State	e Zip Code	Distance Direction	Nearest Town of <u>New Gorden</u>		
Telephone No. (901) 605 - 074	47		or New Gorden		
	Well / Bore	hole Data			
Date drilling started: 9-11-08 Date dril	lling completed: 9-11-0	Hole depth: 170	Hole diameter: 63/4		
Location of the source of any surface water used for drilling:					
Purpose of borehole (check one): Water We	IIGeotechnical/Geolo	gical Investigation Ground	Source Heat Pump		
	urvey Other ( <i>describe</i> )		r		
If drilling is not related t	o water well construction	, skip the remainder of this blo	ick		
Purpose of Well (check one): Home Ind	dustrial Public Supply	Irrigation Fish Culture	Other:		
If a flowing well, method of flow regulation					
Static Water Level: 100 feet abo	ve obelow (circle one) la	nd surface Date measured:	9-11-08		
Method of Measurement (circle one) steel tape electric tape air line other: <u>String (meight</u>					
Well depth: 100 Well grouted to a depth of 10 feet Type of grout (circle one): Neat Cement Bentonite Mix					
Casing length: 150 feet Casing diameter: 4 inches Type of casing: $\beta \cup \zeta$					
Screen length: $\frac{\partial 0}{\partial t}$ feet Screen diameter: $\frac{d}{dt}$ inches Type of screen: $\rho d t$					
Screen slot size: <u>, 010</u> inches	Setting depth: From	50 feet to (	) O feet		
Type of completion (circle all applicable): Gravel packed Underreamed Telescoped Open hole Natural Development					
Other (describe):					
Top of lap pipe or reduction in casing:	<u>feet</u> . <u>If tele</u>	scoped or more than one screer	1, describe on next page		
			Form: OLWR-SWR-1A (04/08)		
			RECEIVED		

¥

.

0CT 0 8 2008 BY: OLWR


## D-150

## The sketch below only required for water wells

If well telescopes, show depths on sketch. Ground Level\_\_\_\_\_ <u>Description of formations encountered must be provided for all</u> wells and boreholes, unless specifically exempted by regulations

Description of Formations Encountered	From (depth)	To (depth)
clay dirt	Ground Level	10
red'sond	10	30
unite soud	30	65
white day	65	60
white soud	08	100
entite clay	001	110
white sand	110	170
	_	
		1
	-t	1

If more than one screen, show location of each on sketch

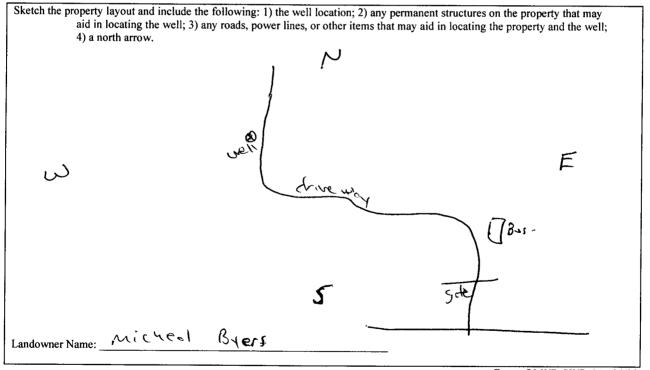

Form: OLWR-SWR-1A (04/08)

I certify that the well/borehole was drilled, constructed, and completed in accordance with all applicable requirements of the Mississippi Department of Environmental Quality and the Mississippi Department of Health regulations, if applicable, and state

laws w. Meson 0-620 6-C) 10-6-08 RECEIVED Signature of Licensee Print Name of Responsible Licensee and License No. Date

0CT 0 8 2008 BY: OLW R

	STATE WELL REPORT	
County: Tote	Part 2 Pump Installer's Completion Report	For Office Use Only:
Permit #:	Mississippi Department of Environmental Quality Office of Land and Water Resources P.O. Box 2309	Aquifer:
Date completed: $9 - (1 - 0 \delta')$	Jackson, MS 39225 (601)961-5210	Well #: <u>D-150</u>
Copy information from block on Part 1	(601)961-5228 (fax)	Elevation:

This part of the report must be completed by a licensed water well contractor or a licensed pump installer. A copy of Part 1 of the report must be attached and both parts filed with the Department at the above address within 30 days of well completion.

Well Owner Information	Well Location
Owner Name: Micheol Byers	Latitude: 34-44-520 Longitude: 89-44-584
Mailing Address: Watefeild rd	Method of Lat/Long (check one): Conventional Survey,
double red metal gates at drivening	USGS quad, Hand-held GPS <u>,</u> Survey-grade GPS
Coldwater MS 38618 City State Zip Code	<u>SE 1/2 SW 1/2 Sec 8 T 45 R 5 W</u>
	Distance Direction Nearest Town
Telephone No. (70() 605-0747	1/2 Miles W/ of ANNI Conclean

	Pump Type Circle one			Power Type Circle one	
Air Lift	Jet	Submersible	Diesel Engine	Gasoline Engine	Natural Gas
Bucket	Piston	Turbine	Electric Motor	Hand	Tractor PTO
Centrifugal	Rotary	Flowing Well	Windmill	Other (specify):	
Other (specify):			Horse Power Rating	of Motor: /1/2	
Date Pump Installed:	9-11-08		Setting Depth:	120	feet
Rated Pump Capacity	20	Gallons Per Minute	Number of Stages: _		

Pump Test Data	Method of Measuring Water Level		
Date Well Tested: <u><u><u><u></u></u><u><u><u></u><u><u></u></u><u><u></u><u><u></u><u><u></u></u><u><u></u><u></u><u></u><u></u><u></u><u></u><u></u></u></u></u></u></u></u></u>	Circle one		
Static Water Level (A): <u>200</u> Feet Below Land Surface	Air Line Electric Measuring Line Steel Tape Other (specify): $sfring from the steel Tape$		
Pumping Water Level (B):Feet Below Land Surface	other (specify): /		
Drawdown [(B) – (A)]:Feet Below Land Surface	For flowing well, measured shut in head:feet		
Test Pumping Rate: Gallons Per Minute	Well yielded $20$ GPM with a drawdown of		
Duration of Pump Test (minimum 4 hours): hours	- feet after $ -$ hours of pumping		

	I HEREBY CERTIFY that the above statements are true to the best	of my knowledge.	
1	Your W. Mon 0-620	Ganal	
	Print/Name of Pump Installer and License No. (if applicable)	Signature of Pump Installer	
		Form: OLWR-SWR	EIVED

0CT 0 8 2008 BY: OLWR