	State Well Report	
County: Tote	Part 1 – Driller's Log	For Office Use Onl
Permit #:	Mississippi Department of Environmental Quality Office of Land and Water Resources	Aquifer:
Driller: Joves w. Mason	P.O. Box 2309	Well #:
	Jackson, MS 39225 (601)961- 5210	L. S. Elevation:
Date drilling completed: 12-19-09	(601)961- 5228 (fax)	E-log #:
State Law requires that this repo	It be prepared by the license holder responsible for it	
Department at the above address	within 30 days of completion of drilling of the well	or borehole.
Information on Well (<i>Landowner if borehole is not f</i>		rehole Location
Owner Name Audry Mayo		" Longitude: $89 \circ 43$,
Mailing Address: <u>38 %</u> wall	AZ Method of Lat/Long (circle or	e): Conventional Survey,
Maning Address: 000 0000000000000000000000000000000	USGS quad, Hand-held	GPS, Survey-grade GPS
	NE 4NE 4 Sec 28	
(<u>oldwater</u> M City Sta	$\frac{3 3 6 1 8}{1000000000000000000000000000000000000$	Nearest Town
Telephone No. (414) 339 - 5764	112 Miles NE	of <u>Bett</u>
Telephone No. (11) 354 378 4		
	e used in drilling and development: <u></u>	
Method of dosing and volume of Chloring Logs run (circle all applicable): No log run Name of organization running log(s): Purpose of borehole (check one): Water W	e used in drilling and development: <u></u>	
Method of dosing and volume of Chloring Logs run (circle all applicable): No log run Name of organization running log(s): Purpose of borehole (check one): Water W Seismic S	e used in drilling and development: <u>M</u> De Electric Gamma Ray Density Sonic Neutron M	Source Heat Pump
Method of dosing and volume of Chloring Logs run (circle all applicable): No log run Name of organization running log(s): Purpose of borehole (check one): Water W Seismic S <u>If drilling is not related</u>	e used in drilling and development: <u>M</u> Electric Gamma Ray Density Sonic Neutron ell <u> Geotechnical/Geological Investigation</u> Ground Survey Other (<i>describe</i>)	Source Heat Pump
Method of dosing and volume of Chloring Logs run (circle all applicable): No log run Name of organization running log(s): Purpose of borehole (check one): Water W Seismic S If drilling is not related Purpose of Well (check one): Home	e used in drilling and development: <u>M</u> Electric Gamma Ray Density Sonic Neutron ell <u>Geotechnical/Geological Investigation</u> Ground Survey Other (<i>describe</i>) to water well construction, skip the remainder of this blocks	Source Heat Pump
Method of dosing and volume of Chloring Logs run (circle all applicable): No log run Name of organization running log(s): Purpose of borehole (check one): Water W Seismic S <u>If drilling is not related</u> Purpose of Well (check one): Home In If a flowing well, method of flow regulation	e used in drilling and development: <u>M</u> Electric Gamma Ray Density Sonic Neutron ell <u>Geotechnical/Geological Investigation</u> Ground Survey Other (<i>describe</i>) to water well construction, skip the remainder of this block ndustrial Public Supply Irrigation Fish Culture	Source Heat Pump <u>ck</u> Other:
Method of dosing and volume of Chloring Logs run (circle all applicable): No log run Name of organization running log(s): Purpose of borehole (check one): Water W Seismic S If drilling is not related Purpose of Well (check one): Home I If a flowing well, method of flow regulation Static Water Level: & dot flow flow for the feet ab	e used in drilling and development: De Electric Gamma Ray Density Sonic Neutron ell Geotechnical/Geological Investigation Ground Survey Other (describe) to water well construction, skip the remainder of this black industrial Public Supply Irrigation Fish Culture n: Valve Other (describe)	Source Heat Pump Other: 12 - うひっひ う
Method of dosing and volume of Chloring Logs run (circle all applicable): No log run Name of organization running log(s): Purpose of borehole (check one): Water W Seismic S If drilling is not related Purpose of Well (check one): Home I If a flowing well, method of flow regulation Static Water Level: $(\bigcirc \overleftarrow{\diamond} \ feet ab$ Method of Measurement (circle one) st Well depth: $1 \le \bigcirc$ Well grouted to a de	e used in drilling and development: <u>M</u> Electric Gamma Ray Density Sonic Neutron ell <u>Geotechnical/Geological Investigation</u> Ground Survey Other (<i>describe</i>) to water well construction, skip the remainder of this bla ndustrial Public Supply Irrigation Fish Culture n: Valve <u>M</u> Other (describe) nove or below circle one) land surface Date measured: eel tape electric tape air line other: <u>Str</u> pth of <u>(O</u> feet Type of grout (circle one): Neat Cem	Source Heat Pump ck Other: 12 - 30 - 23 case - 12 - 20 - 23
Method of dosing and volume of Chloring Logs run (circle all applicable): No log run Name of organization running log(s): Purpose of borehole (check one): Water W Seismic S If drilling is not related Purpose of Well (check one): Home I If a flowing well, method of flow regulation Static Water Level:feet ab Method of Measurement (circle one) st Well depth: Well grouted to a de Casing length: feet Casing	e used in drilling and development: <u>M</u> Electric Gamma Ray Density Sonic Neutron ell <u>Geotechnical/Geological Investigation</u> Ground Survey Other (<i>describe</i>) <i>to water well construction, skip the remainder of this bla</i> ndustrial Public Supply Irrigation Fish Culture n: Valve <u>M</u> Other (describe) ove of below (circle one) land surface Date measured: eel tape electric tape air line other: <u>Str</u> pth of <u>(O</u> feet Type of grout (circle one): Neat Cem- ag diameter: <u>U</u> inches Type of casing:	Source Heat Pump ck Other: 12 - 30 - 23 cy - 4 - 23 cy - 4 - 23 ent Bentonite Mix pu = 4
Method of dosing and volume of Chloring Logs run (circle all applicable): No log run Name of organization running log(s): Purpose of borehole (check one): Water W Seismic S If drilling is not related Purpose of Well (check one): Home I If a flowing well, method of flow regulation Static Water Level:feet ab Method of Measurement (circle one) st Well depth: Well grouted to a de Casing length: feet Casing	e used in drilling and development: <u>M</u> Electric Gamma Ray Density Sonic Neutron ell <u>Geotechnical/Geological Investigation</u> Ground Survey Other (<i>describe</i>) to water well construction, skip the remainder of this bla ndustrial Public Supply Irrigation Fish Culture n: Valve <u>M</u> Other (describe) nove or below circle one) land surface Date measured: eel tape electric tape air line other: <u>Str</u> pth of <u>(O</u> feet Type of grout (circle one): Neat Cem	Source Heat Pump ck Other: 12 - 30 - 23 cy - 4 - 23 cy - 4 - 23 ent Bentonite Mix
Method of dosing and volume of Chloring Logs run (circle all applicable): No log run Name of organization running log(s): Purpose of borehole (check one): Water W Seismic S If drilling is not related Purpose of Well (check one): Home I If a flowing well, method of flow regulation Static Water Level: feet ab Method of Measurement (circle one) st Well depth: 150 Well grouted to a de Casing length: feet Casing Screen length: feet Screen	e used in drilling and development: <u>M</u> Electric Gamma Ray Density Sonic Neutron ell <u>Geotechnical/Geological Investigation</u> Ground Survey Other (<i>describe</i>) <i>to water well construction, skip the remainder of this bla</i> ndustrial Public Supply Irrigation Fish Culture n: Valve <u>M</u> Other (describe) ove of below (circle one) land surface Date measured: eel tape electric tape air line other: <u>Str</u> pth of <u>(O</u> feet Type of grout (circle one): Neat Cem- ag diameter: <u>U</u> inches Type of casing:	Source Heat Pump ck Other: 12 - 30 - 0.9 $c_{2} - 20 - 0.9$ $c_{3} - 20 - 0.9$
Method of dosing and volume of Chlorine Logs run (circle all applicable): No log run Name of organization running log(s): Purpose of borehole (check one): Water W Seismic S If drilling is not related Purpose of Well (check one): Home I If a flowing well, method of flow regulation Static Water Level: $(\begin{array}{c} & \\ & \\ & \\ & \\ & \end{array}$ feet ab Method of Measurement (circle one) st Well depth: $1 \leq O$ Well grouted to a de Casing length: $1 \leq O$ Well grouted to a de Screen length: $(\begin{array}{c} & \\ & \\ & \\ & \\ & \\ & \\ & \\ & \\ & \\ & $	e used in drilling and development: \underline{M} Electric Gamma Ray Density Sonic Neutron ell $\underline{\checkmark}$ Geotechnical/Geological Investigation Ground SurveyOther (<i>describe</i>) to water well construction, skip the remainder of this bla industrialPublic Supply Irrigation Fish Culture n: ValveMOther (describe) nove of below (circle one) land surface Date measured: eel tape electric tape air line other: <u></u> pth of <u>(O</u> feet Type of grout (circle one): Neat Cem- ng diameter: <u></u> inches Type of screen:	Source Heat Pump ck Other: 12 - 30 - 23 case - 12 - 20 - 23
Method of dosing and volume of Chlorine Logs run (circle all applicable): No log run Name of organization running log(s): Purpose of borehole (check one): Water W Seismic S If drilling is not related Purpose of Well (check one): Home I If a flowing well, method of flow regulation Static Water Level: $(\begin{array}{c} & \\ & \\ & \\ & \\ & \end{array}$ feet ab Method of Measurement (circle one) st Well depth: $1 \leq O$ Well grouted to a de Casing length: $1 \leq O$ Well grouted to a de Screen length: $(\begin{array}{c} & \\ & \\ & \\ & \\ & \\ & \\ & \\ & \\ & \\ & $	e used in drilling and development: \underline{M} Electric Gamma Ray Density Sonic Neutron ell $$ Geotechnical/Geological Investigation Ground Survey Other (<i>describe</i>) to water well construction, skip the remainder of this bla ndustrial Public Supply Irrigation Fish Culture n: Valve \underline{M} Other (describe) n: Valve \underline{M} Other (describe) to ve of below circle one) land surface Date measured: the electric tape air line other: \underline{Str} pth of $\underline{(0)}$ feet Type of grout (circle one): Neat Cem- ag diameter: $\underline{'}$ inches Type of screen: $$ setting depth: From $\underline{I'(0)}$ feet to \underline{ISO}	Source Heat Pump ck Other: 12 - 30 - 23 c - 20 - 23

RECEIVED JAN 1 4 2010 BY: OLWR



The sketch below only required for water wells




Ground Level_____

	wells and boreholes, unless specifically exempted by regulations		
<u>:h</u> .			
	Description of Formations Encountered		To (depth)
	cial dist	Ground Level	15
	white soul	15	40
	white clay	40	70
	fire white some	70	(70)
	Coorse white road	120	(50)
	· · · · · · · · · · · · · · · · · · ·		
	· · · · · · · · · · · · · · · · · · ·		

Description of formations encountered must be provided for all

If more than one screen, show location of each on sketch

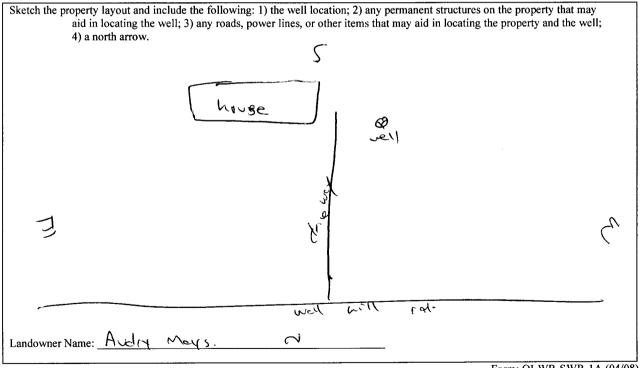

Form: OLWR-SWR-1A (04/08)

I certify that the well/borehole was drilled, constructed, and completed in accordance with all applicable requirements of the Mississippi Department of Environmental Quality and the Mississippi Department of Health regulations, if applicable, and state

laws. 0-620 1-9-10 Joes w. Mesos s v. Ma RE Signature of Licensee GEWED Date Print Name of Responsible Licensee and License No.

JAN 14 2010

BY: OLWR

STATE WELL REPORT			
County: Tate	Part 2 Pump Installer's Completion Report	For Office Use Only:	
Permit #:	Mississippi Department of Environmental Quality	Aquifer: D 152	
Driller: Dues w. Moson	Office of Land and Water Resources P.O. Box 2309		
Date completed: $(2 - 30 - 09)$	Jackson, MS 39225 (601)961-5210	Well #:	
Copy information from block on Part 1	(601)961-5228 (fax)	Elevation:	

This part of the report must be completed by a licensed water well contractor or a licensed pump installer. A copy of Part 1 of the
report must be attached and both parts filed with the Department at the above address within 30 days of well completion.Well Owner InformationWell Location

Well Owner Information	Well Location
Owner Name: Audry Meyer	Latitude: 34.42,708 Longitude: 89-43-568
Mailing Address: <u>2836 wall will id</u> Coldwater MJ <u>38618</u> City State Zip Code Telephone No. (<u>414</u>) <u>339 - 5764</u>	Method of Lat/Long (check one): Conventional Survey, USGS quad, Hand-held GPS, Survey-grade GPS $NE_{4} NE_{4} Sec_{2} 8 T_{4} Sc_{2} R_{5} \omega$ Distance Direction Nearest Town $I_{2} Miles_{2} NE_{5} of_{3} z t t$
Pump Type	Power Type Circle one

	Pump Ty Circle o			Circle one	
Air Lift	Jet	Submersible	Diesel Engine	Gasoline Engine	Natural Gas
Bucket	Piston	Turbine	Electric Motor	Hand	Tractor PTO
Centrifugal	Rotary	Flowing Well	Windmill	Other (specify):	
Other (specify):			Horse Power Ratir	-	
Date Pump Installed:	12-20-	-09	Setting Depth:	8,0	feet
Rated Pump Capacity	y:O	Gallons Per Minute	Number of Stages:	8	

Pump Test Data	Method of Measuring Water Level Circle one
Date Well Tested: <u>しーマロービア</u> Static Water Level (A): <u></u> Gマ Feet Below Land Surface	Air Line Electric Measuring Line Steel Tape Other (specify): <u>String Incish</u>
Pumping Water Level (B): Feet Below Land Surface	
Drawdown [(B) – (A)]:Feet Below Land Surface	For flowing well, measured shut in head:feet
Test Pumping Rate: topological Gallons Per Minute Duration of Pump Test (minimum 4 hours): 34 hours	Well yielded $\underline{l \circ}$ GPM with a drawdown of $\underline{\ }$ feet after $\underline{\ }$ hours of pumping

I HEREBY CERTIFY that the above statements are true to the best of	of my knowledge.
Jones W. Meson U-620	Ques w. Man
Print Name of Pump Installer and License No. (if applicable)	Signature of Pump Installer Form: OLWR-SWR-1B (04/08)
	RECEIVED
	JAN 1 4 2010
	BY: OLWP