

**MISSISSIPPI
BOARD OF WATER COMMISSIONERS**
416 North State Street
Jackson, Mississippi 39201

WATER WELL DRILLERS LOG

Date
D 2003
2-67

2-25 1967 Harris Bros Zato
date well completed firm name county well located

LANDOWNER: Harvey Wallace

description of formations encountered	from	to
<u>top soil</u>	<u>0</u>	<u>20</u>
<u>clay + sand</u>	<u>20</u>	<u>25</u>
<u>fine sand</u>	<u>25</u>	<u>115</u>
<u>coarse h. sand</u>	<u>115</u>	<u>130</u>

Independence Miss.
(mailing address)


WELL LOCATION:
sec. 17 T 4 N R 5 E
2 1/2 miles E of Independence
(distance) (direction) (nearest town)

WELL PURPOSE: home
(home, irrigation, municipal, industrial)

WELL COMPLETION DATA:


- diameter (inches) 4
- total depth (feet) 130
- static water level (feet) 50 below top of ground.
- casing plastic 123,
(material) (depth)
4 if telescope see back.
(size)
- screen 7' 123
(length) (depth to top)
008 plastic
(size) (material)
- pump 3/4 7
(HP) (yield gpm)
elec.
(type power)
- electric log no
(yes or no)
me
(organization running log)
- how well bottom plugged back
shot

DRILLERS REMARKS:

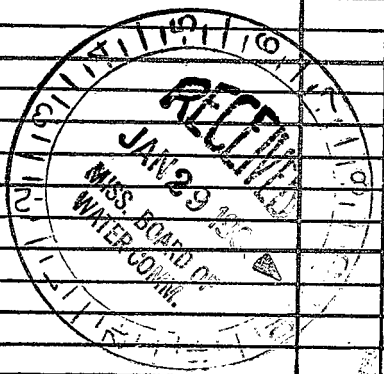

If well telescopes please sketch and show depths.

GROUND LEVEL

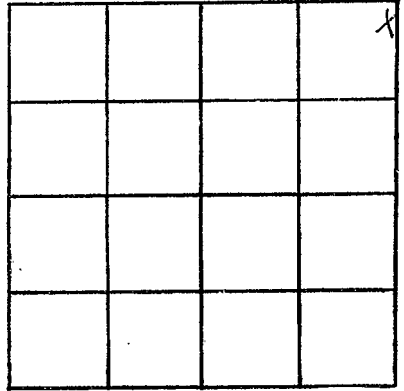

SECTION 17

Please indicate well location X.

ADDITIONAL INFORMATION

If more than one screen,
show locations of each on sketch.