

July
D 2005
7-68

MISSISSIPPI
 BOARD OF WATER COMMISSIONERS
 416 North State Street
 Jackson, Mississippi 39201

WATER WELL DRILLERS LOG

7/11 19 *68* *Bob Smith* *Late*
 date well completed firm name county well located

LANDOWNER: *Whitehead*

description of formations encountered	depth	
	from	to
<i>top soil</i>	<i>0</i>	<i>10</i>
<i>red clay</i>	<i>10</i>	<i>40</i>
<i>white clay</i>	<i>40</i>	<i>60</i>
<i>white sand</i>	<i>60</i>	<i>200</i>

Independence, Miss.
 (mailing address)

WELL LOCATION:
 sec. *24* T. *4* N. R. *5* E.
10 miles *east* of *Ind*
 (distance) (direction) (nearest town)


WELL PURPOSE: *home*
 (home, irrigation, municipal, industrial)

WELL COMPLETION DATA:

- (1) diameter (inches) *4*
- (2) total depth (feet) *200*
- (3) static water level (feet) *120* below above top of ground.
- (4) casing *plastic* *200*
 (material) (depth)
 (size) if telescope see back.
- (5) screen *20* *180*
 (length) (depth to top)
4" *plastic*
 (size) (material)
- (6) pump *1/2* *10*
 (HP) (yield gpm)
Elec.
 (type power)
- (7) electric log *no*
 (yes or no)
 (organization running log)


(8) how well bottom plugged *plugged*

DRILLERS REMARKS:
good drilling

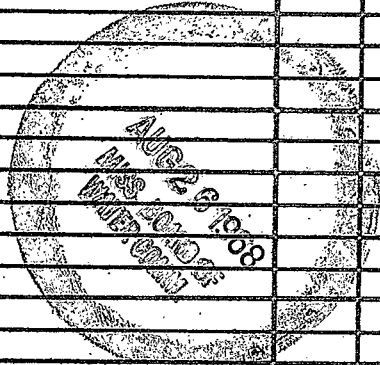

If well telescopes please sketch and show depths.

GROUND LEVEL

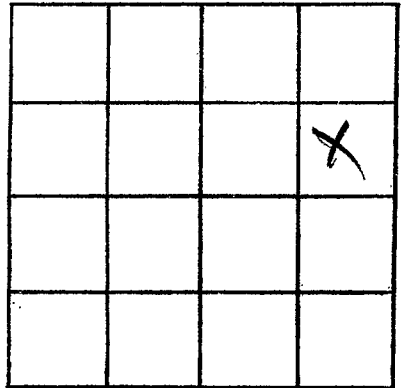

SECTION _____

Please indicate well location X.

ADDITIONAL INFORMATION

If more than one screen, show locations of each on sketch.