

Date  
 D 2000  
 7-68

MISSISSIPPI  
 BOARD OF WATER COMMISSIONERS  
 416 North State Street  
 Jackson, Mississippi 39201

WATER WELL DRILLERS LOG

7/17 1968 Bob Smith Date  
 date well completed firm name county well located

LANDOWNER: Abbott  
 Independence Miss  
 (mailing address)

description of formations encountered	from	to
top soil	0	20
red clay	10	40
white clay	40	60
white sand	60	200


WELL LOCATION:  
 sec. 28 T. 4 N. R. 5 E  
 1.0 miles east of Ind  
 (distance) (direction) (nearest town)

WELL PURPOSE: Home  
 (home, irrigation, municipal, industrial)

- WELL COMPLETION DATA:
- (1) diameter (inches) 4
  - (2) total depth (feet) 180
  - (3) static water level (feet) 135 below top of ground.
  - (4) casing plastic 180 (material) (depth)
  - (size) if telescope see back.
  - (5) screen 20 160 (length) (depth to top)
  - 4 plastic (size) (material)
  - (6) pump 1/2 10 (HP) (yield gpm)
  - Elec. (type power)
  - (7) electric log 20 (yes or no)
  - (organization running log)

(8) how well bottom plugged plugged

DRILLERS REMARKS:  
 good drilling

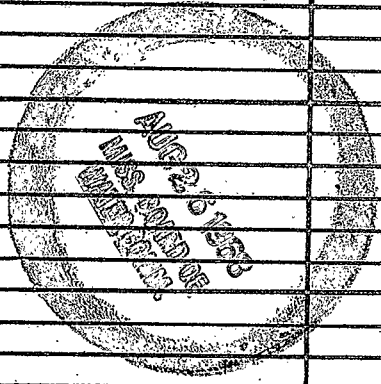

If well telescopes please sketch and show depths.

GROUND LEVEL

			X

SECTION \_\_\_\_\_

Please indicate well location X.

ADDITIONAL INFORMATION

If more than one screen,  
show locations of each on sketch.