

**MISSISSIPPI
BOARD OF WATER COMMISSIONERS**
416 North State Street
Jackson, Mississippi 39201

WATER WELL DRILLERS LOG

Late
D 2007

Late

10-1-75 19 *Atkinson* *Miss* *Mississippi*
date well completed firm name county well located

LANDOWNER:
John W. Milner
Rt 2 Bygdalia Miss
(mailing address)

description of formations encountered	from	to
<i>CLAY</i>	<i>0</i>	<i>30</i>
<i>SAND</i>	<i>30</i>	<i>110</i>
<i>CLAY</i>	<i>110</i>	<i>125</i>
<i>SAND</i>	<i>125</i>	<i>155</i>

WELL LOCATION:
sec. *4* T *4* N R. *5* E *15E*
7 miles *S* of *Bygdalia*
(distance) (direction) (nearest town)

WELL PURPOSE: *home*
(home, irrigation, municipal, industrial)

- WELL COMPLETION DATA:
- (1) diameter (inches) *4"*
 - (2) total depth (feet) *155*
 - (3) static water level (feet) *120* below top of ground.
 - (4) casing *P.V.P.*; *145*
(material) (depth)
 - (size) if telescope see back.
 - (5) screen *10* *145*
(length) (depth to top)
 - 4"* *P.V.P.*
(size) (material)
 - (6) pump *3/4* *10*
(HP) (yield gpm)
 - elec.*
(type power)
 - (7) electric log _____
(yes or no)


(organization running log) _____
(8) how well bottom plugged *C.M.P.*

RECEIVED
OCT 29 1975

DRILLERS REMARKS:

If well telescopes please sketch and show depths.

GROUND LEVEL

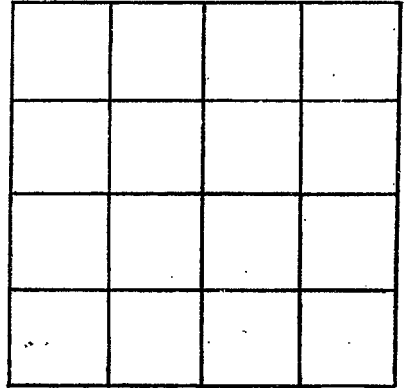

SECTION _____

Please indicate well location X.

ADDITIONAL INFORMATION

If more than one screen, show locations of each on sketch.