

Date  
 D 2008

MISSISSIPPI  
 BOARD OF WATER COMMISSIONERS  
 416 North State Street  
 Jackson, Mississippi 39201

WATER WELL DRILLERS LOG

Date

Atkinson & Fine

0-1-75 19  
 date well completed

firm name

county well located

LANDOWNER:  
 Walter C. Jones  
 Rt 2 Byhalia Miss.  
 (mailing address)

description of formations encountered	from	to
CLAY	0	30
SAND	30	110
CLAY	110	125
SAND	125	153

WELL LOCATION:  
 sec. 4 T 4 N R 5 E 15E  
 7 miles S of Byhalia  
 (distance) (direction) (nearest town)


WELL PURPOSE: home  
 (home, irrigation, municipal, industrial)

- WELL COMPLETION DATA:
- (1) diameter (inches) 4"
  - (2) total depth (feet) 153
  - (3) static water level (feet) 115 below top of ground.
  - (4) casing P.V.C. 145 (material) (depth)
  - (size) if telescope see back.
  - (5) screen 10 145 (length) (depth to top)
  - 3/4" P.V.C. (size) (material)
  - (6) pump 3/4 10 (HP) (yield gpm)
  - elec (type power)
  - (7) electric log (yes or no)

(organization running log)

(8) how well bottom plugged CAP

DRILLERS REMARKS:

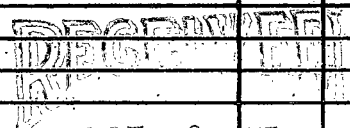


OCT 20 1975

MISS. BD. OF WATER COMM

If well telescopes please sketch and show depths.

GROUND LEVEL

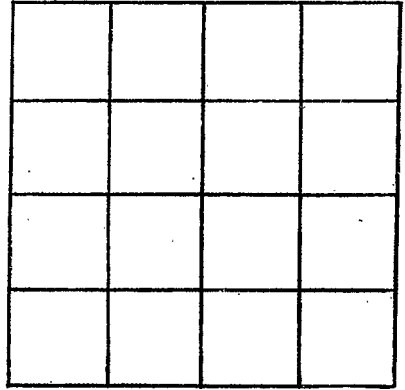

SECTION \_\_\_\_\_

Please indicate well location X.

ADDITIONAL INFORMATION

If more than one screen,  
show locations of each on sketch.