

**MISSISSIPPI
BOARD OF WATER COMMISSIONERS**
416 North State Street
Jackson, Mississippi 39201

WATER WELL DRILLERS LOG

TATE
D 2007
12-13-75

12-13 1975 *W.A. Mason* *Jato*
date well completed firm name county well located

LANDOWNER:
B.W. Watson
Rt. 3, Colwater Miao
(mailing address)

description of formations encountered

description of formations encountered	from	to
<i>clay dirt</i>	<i>0</i>	<i>10</i>
<i>Red sand</i>	<i>10</i>	<i>40</i>
<i>white sand</i>	<i>40</i>	<i>140</i>

WELL LOCATION:
sec. 8 T. 4 N. R. 5 E. W
1/2 miles WEST of Wakefield
(distance) (direction) (nearest town)

WELL PURPOSE: *Home*
(home, irrigation, municipal, industrial)

WELL COMPLETION DATA:

(1) diameter (inches) 4"

(2) total depth (feet) 140'

(3) static water level (feet) 72' below top of ground.

(4) casing Plastic, 120'
(material) (depth)
4" if telescope see back.
(size)

(5) screen 10', 120'
(length) (depth to top)
4", Plastic
(size) (material)

(6) pump 1 1/2 30
(HP) (yield gpm)
electric
(type power)

(7) electric log NO
(yes or no)

(organization running log)


(8) how well bottom plugged cap on screen

DRILLERS REMARKS:

RECEIVED
FEB 17 1976

If well telescopes please sketch and show depths.

GROUND LEVEL

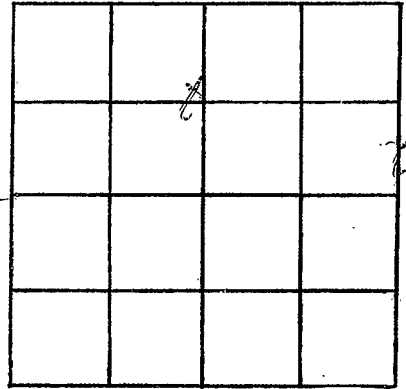

SECTION

Please indicate well location X.

ADDITIONAL INFORMATION

If more than one screen, show locations of each on sketch.