

Tate
 D 2013
 5/30/76

MISSISSIPPI
 BOARD OF WATER COMMISSIONERS
 416 North State Street
 Jackson, Mississippi 39201

15E

WATER WELL DRILLERS LOG

Tate
 Hancock

5-30-
 date well completed

1976 W.P. Mason
 firm name

county well located


LANDOWNER:	description of formations encountered	from	to
(mailing address)			
Maurie Spears	Clay dirt	to	10
RR-1 - Bayhala m'ss.	Red sand	10	50
	white sand	50	150
WELL LOCATION:			
sec. 18 T. 4 N. R. 5 E			
1/2 miles SE of Markis Cross			
WELL PURPOSE: Home (home, irrigation, municipal, industrial)			
WELL COMPLETION DATA:			
(1) diameter (inches) 4"			
(2) total depth (feet) 150'			
(3) static water level (feet) 107' below top of ground.			
(4) casing Plastic, 140' (material) (depth)			
4" (size) if telescope see back.			
(5) screen 10' 140' (length) (depth to top)			
4" PVC-Plastic (size) (material)			
(6) pump 3/4 10 (HP) (yield gpm)			
electric (type power)			
(7) electric log No. (yes or no)			
(organization running log)			
(8) how well bottom plugged cap on screen			
DRILLERS REMARKS:			

RECEIVED
 JUL 7 - 1977

Miss. Bd. of Water Comm.

If well telescopes please sketch and show depths.

GROUND LEVEL

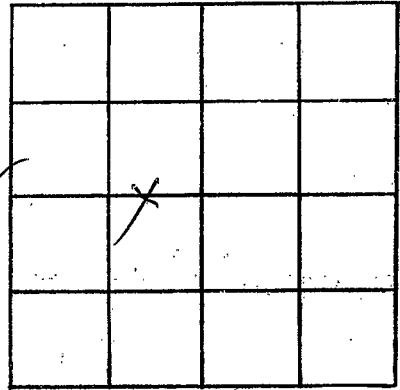

SECTION 18

Please indicate well location X.

ADDITIONAL INFORMATION

If more than one screen, show locations of each on sketch.