

late
D 2014
7-21-76

MISSISSIPPI
 BOARD OF WATER COMMISSIONERS
 416 North State Street
 Jackson, Mississippi 39201

WATER WELL DRILLERS LOG

7-21 1976 Hicks Well Co. State
 date well completed firm name county well located


| LANDOWNER: <u>Crockett Williams</u> | description of formations encountered | from | to |
|---|---------------------------------------|-----------|------------|
| <u>Pch 3</u> | <u>Red clay</u> | <u>0</u> | <u>10</u> |
| <u>Coldwater Miss.</u> (mailing address) | <u>Red clay & sand</u> | <u>10</u> | <u>60</u> |
| WELL LOCATION: sec. <u>31</u> T. <u>24</u> N. R. <u>5</u> E. (W) <u>1</u> miles <u>SE</u> of <u>Independence</u> (distance) (direction) (nearest town) | <u>White Sand</u> | <u>60</u> | <u>105</u> |
| WELL PURPOSE: <u>Home</u> (home, irrigation, municipal, industrial) | | | |
| WELL COMPLETION DATA: | | | |
| (1) diameter (inches) <u>4"</u> | | | |
| (2) total depth (feet) <u>105</u> | | | |
| (3) static water level (feet) <u>60</u> below above top of ground. | | | |
| (4) casing <u>PVC</u> , <u>105</u> (material) (depth) (size) if telescope see back. | | | |
| (5) screen <u>4ft</u> , <u>107</u> (length) (depth to top) | | | |
| (6) pump <u>4"</u> , <u>gravel</u> (size) (material) | | | |
| (6) pump <u>1/2</u> , <u>10</u> (HP) (yield gpm) | | | |
| (7) electric log <u>220</u> (type power) | | | |
| (7) electric log <u>NO</u> (yes or no) | | | |
| (organization running log) | | | |
| (8) how well bottom plugged <u>CAP</u> | | | |
| DRILLERS REMARKS: | | | |

RECEIVED
 JUL 28 1976

MISS. BD. OF WATER COMMISSIONERS

If well telescopes please sketch and show depths.

GROUND LEVEL

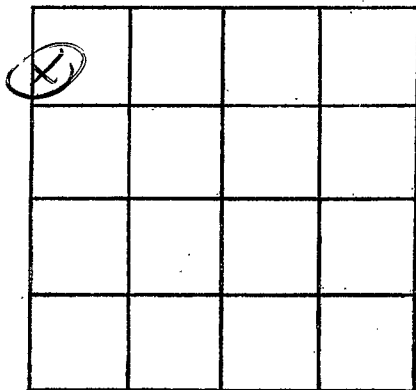

SECTION 31

Please indicate well location X.

ADDITIONAL INFORMATION

Lined area for additional information.

RECEIVED

If more than one screen, show locations of each on sketch.