

Need better location - This location
about 12 mi E of Coldwater

MISSISSIPPI
BOARD OF WATER COMMISSIONERS
416 North State Street
Jackson, Mississippi 39201

consulted 7/5/77

Late
& D 2007
3-17-77

WATER WELL DRILLERS LOG

3-17-77 Deeks Well Co. Late
date well completed firm name county well located

LANDOWNER: Vasti Kells
Rt. 4
Coldwater, Mo.
(mailing address)

description of formations encountered	from	to
	<u>Red Clay</u>	<u>0</u>
<u>Red Sand</u>	<u>40</u>	<u>50</u>
<u>White Sand</u>	<u>50</u>	<u>100</u>

WELL LOCATION:
sec 20 T 4 N R 5 E
7 miles (distance) W (direction) of Coldwater (nearest town)

2.2 Miles S New Hudson

WELL PURPOSE: Home
(home, irrigation, municipal, industrial)

WELL COMPLETION DATA:
(1) diameter (inches) 4
(2) total depth (feet) 100
(3) static water level (feet) 93 below/above top of ground.
(4) casing PVC 100
(material) (depth)
(size) if telescope see back.
(5) screen 4' 96'
(length) (depth to top)
4" gravel type
(size) (material)
(6) pump 1/2 10
(HP) (yield gpm)
220V
(type power)
(7) electric log No
(yes or no)
(organization running log)
(8) how well bottom plugged Cap


DRILLERS REMARKS:

RECEIVED
MAY 13 1977

MISS. Bd. OF WATER COMMISSIONERS

If well telescopes please sketch and show depths.

GROUND LEVEL

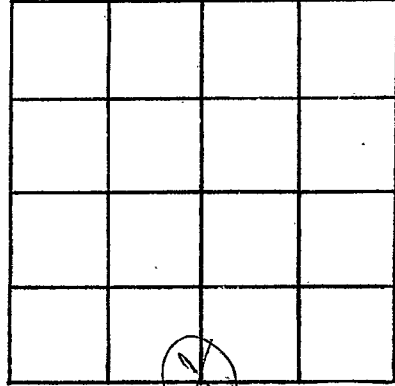

SECTION 20

Please indicate well location X.

ADDITIONAL INFORMATION

If more than one screen, show locations of each on sketch.