

Date  
 D 2018  
 4-19-77

MISSISSIPPI  
 BOARD OF WATER COMMISSIONERS  
 416 North State Street  
 Jackson, Mississippi 39201

WATER WELL DRILLERS LOG

15E

77 W.O. Mason  
 Water Well Drilling Co.

Jale

4-19-1977 date well completed

firm name

county well located

LANDOWNER:

Fred Kelley  
 P.O. Coffeyville Miss  
 (mailing address)

description of formations encountered

from to

clay soil	0	20
Red sand	20	80
white sand	80	142

WELL LOCATION:

sec 20 T 4 N R 5 E  
 1 1/2 miles west of (nearest town)

WELL PURPOSE: Home  
 (home, irrigation, municipal, industrial)

WELL COMPLETION DATA:

- (1) diameter (inches) 4"
- (2) total depth (feet) 142'
- (3) static water level (feet) 80' below top of ground
- (4) casing Plastic 132' (material) (depth)  
 4" (size) if telescope see back.
- (5) screen 10' 132' (length) (depth to top)  
 4" Plastic (size) (material)
- (6) pump 3/4 HP 10 (yield gpm)  
 electric (type power)
- (7) electric log No (yes or no)

(organization running log)

(8) how well bottom plugged cap


DRILLERS REMARKS:

RECEIVED  
 JUL 7 - 1977

MISS. RD. OF WATER COMMISSIONERS

If well telescopes please sketch and show depths.

GROUND LEVEL

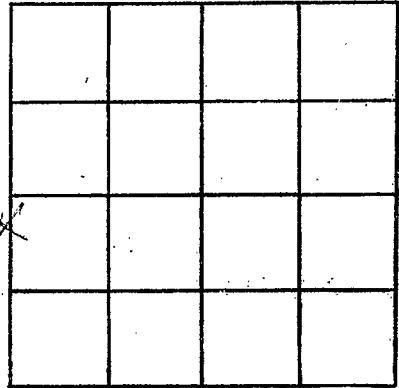

SECTION

20

Please indicate well location X.

ADDITIONAL INFORMATION

If more than one screen, show locations of each on sketch.