

TATE
D 209
5-5-77

MISSISSIPPI
BOARD OF WATER COMMISSIONERS
416 North State Street
Jackson, Mississippi 39201

WATER WELL DRILLERS LOG

5-5 1977 *Hicks Well Co.* *Tate*
date well completed firm name county well located

LANDOWNER: *Key Jeffries*
Rt. 4
Coldwater, Mo.
(mailing address)

description of formations encountered	from	to
<i>Red Clay</i>	<i>0</i>	<i>30</i>
<i>Red Clay & Sand</i>	<i>30</i>	<i>90</i>
<i>White Sand</i>	<i>90</i>	<i>137</i>

WELL LOCATION:
sec. *17* T. *4* N. R. *5* E.
10 miles *NE* of *Coldwater*
(distance) (direction) (nearest town)

WELL PURPOSE: *drine*
(home, irrigation, municipal, industrial)

- WELL COMPLETION DATA:
- (1) diameter (inches) *4*
 - (2) total depth (feet) *137*
 - (3) static water level (feet) *90* below above top of ground.
 - (4) casing *PVC* *137*
(material) (depth)
(size) If telescope see back.
 - (5) screen *7* *130*
(length) (depth to top)
4" *gravel type*
(size) (material)
 - (6) pump *1/2* *10*
(HP) (yield gpm)
220V
(type power)
 - (7) electric log *No*
(yes or no)
 - (organization running log)
 - (8) how well bottom plugged *Cap*


DRILLERS REMARKS:

RECEIVED
MAY 13 1977

MISS. BD. OF WATER COMMS

If well telescopes please sketch and show depths.

GROUND LEVEL

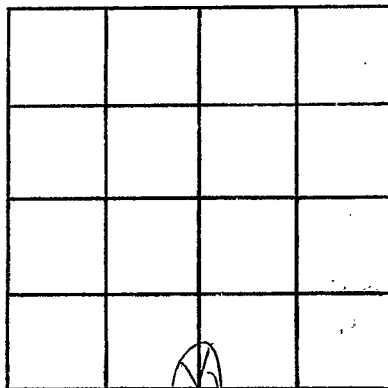

SECTION 17

Please indicate well location X.

ADDITIONAL INFORMATION

If more than one screen, show locations of each on sketch.