

Tate
D. J. J.
8/12/77

MISSISSIPPI
BOARD OF WATER COMMISSIONERS
416 North State Street
Jackson, Mississippi 39201

WATER WELL DRILLERS LOG

8-12-1977 *W. A. Mason Water Well Contr.* *Tate*
date well completed firm name county well located

LANDOWNER:
Mt. Newal Church of God
R.F.D. Coldwater Miss.
(mailing address)

description of formations encountered	from	to
<i>hard dirt</i>	<i>0</i>	<i>10</i>
<i>Red sand</i>	<i>10</i>	<i>20</i>
<i>gravel</i>	<i>20</i>	<i>30</i>
<i>white sand</i>	<i>30</i>	<i>133</i>

WELL LOCATION:
sec. *5* T. *4* N. R. *5* E. *(W)*
1 1/2 miles *E* of *Wakarusa*
(distance) (direction) (nearest town)

WELL PURPOSE: *Church*
(home, irrigation, municipal, industrial)

- WELL COMPLETION DATA:
- (1) diameter (inches) *4"*
 - (2) total depth (feet) *133'*
 - (3) static water level (feet) *92'* below top of ground
 - (4) casing *Plasto* *123'*
(material) (depth)
4" if telescope see back.
(size)
 - (5) screen *10'* *123'*
(length) (depth to top)
4" *Plasto*
(size) (material)
 - (6) pump *3/4* *10*
(HP) (yield gpm)
electric
(type power)
 - (7) electric log *No*
(yes or no)

(organization running log)

(8) how well bottom plugged *Cap*


DRILLERS REMARKS:

RECEIVED

DEC 12 1977

If well telescopes please sketch and show depths.

GROUND LEVEL

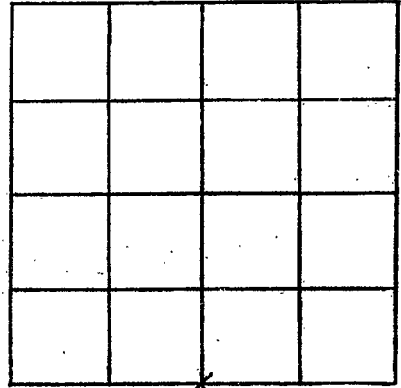

SECTION 5

Please indicate well location X.

ADDITIONAL INFORMATION

If more than one screen, show locations of each on sketch.