

TATE
D 2022
8-12-77

MISSISSIPPI
BOARD OF WATER COMMISSIONERS
416 North State Street
Jackson, Mississippi 39201

WATER WELL DRILLERS LOG

8-12-77 19 date well completed
Hicks well CO firm name
TATE county well located

LANDOWNER: Wall Hill Baptist Church
P.O. 2 Coldwater
(mailing address)

description of formations encountered	from	to
R-CLAY	0	20
R-SAND & CLAY	20	40
Blue CLAY	40	120
W.S.	120	147

WELL LOCATION:
sec. 21 T-4 N R-5 E
S W
2 1/2 miles NE of Bett
(distance) (direction) (nearest town)

WELL PURPOSE: CHURCH
(home, irrigation, municipal, industrial)

WELL COMPLETION DATA:

(1) diameter (inches) 4"

(2) total depth (feet) 147

(3) static water level (feet) 100 below top of ground.

(4) casing PVC 140 (material) (depth)
(size) If telescope see back.

(5) screen 7' 147 (length) (depth to top)
4" INSID GRAVEL (size) (material)

(6) pump 1 1/2 10 (HP) (yield gpm)
EIC (type power)

(7) electric log NO (yes or no)
(organization running log)


(8) how well bottom plugged CAP

DRILLERS REMARKS:

RECEIVED
AUG 29 1977
MISS. BD. OF WATER COMM.

If well telescopes please sketch and show depths.

GROUND LEVEL

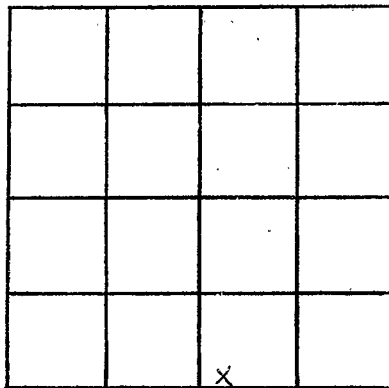

SECTION 2

Please indicate well location X.

ADDITIONAL INFORMATION

If more than one screen, show locations of each on sketch.