

TATE
D
2014

**MISSISSIPPI
BOARD OF WATER COMMISSIONERS**
416 North State Street
Jackson, Mississippi 39201

WATER WELL DRILLERS LOG

10-20-77 19 Bob Smithwell Sr. Jate
 date well completed firm name county well located

LANDOWNER:
Harold Johnson
Collinstown, Miss
 (mailing address)

description of formations encountered	from	to
<u>top soil</u>	<u>0</u>	<u>5</u>
<u>red clay</u>	<u>5</u>	<u>40</u>
<u>sand</u>	<u>40</u>	<u>190</u>

WELL LOCATION:
 sec. 31 T 4 N R 6 E S 5
0 miles (distance) of 0 (direction) of Betts (nearest town)

WELL PURPOSE:
 home, irrigation, municipal, industrial

WELL COMPLETION DATA:

(1) diameter (inches) 4 1/2

(2) total depth (feet) 190

(3) static water level (feet) 80 below top of ground

(4) casing galv (material), 190 (depth)

(size) if telescope see back.

(5) screen 10 (length), 180 (depth to top)

4 1/2 (size), plastic (material)

(6) pump 3/4 (HP), 10 (yield gpm)

Euler (type power)

(7) electric log (yes or no)

(organization running log)

(8) how well bottom plugged

RECEIVED


MAY 30 1978

DRILLERS REMARKS:

MISS. Bd. OF WATER COMM.

If well telescopes please sketch and show depths.

GROUND LEVEL

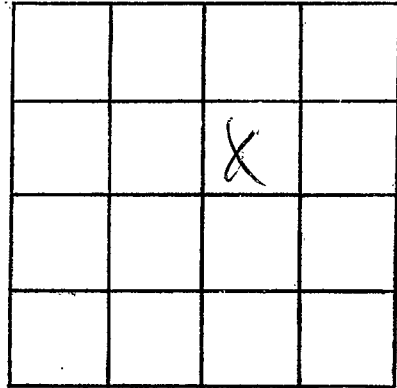

SECTION _____

Please indicate well location X.

ADDITIONAL INFORMATION

If more than one screen,
show locations of each on sketch.