

TATE  
D 2025  
1/4/78

MISSISSIPPI  
BOARD OF WATER COMMISSIONERS  
416 North State Street  
Jackson, Mississippi 39201

WATER WELL DRILLERS LOG

1-4 1978 Hick Well Co. Tate  
date well completed firm name county well located

LANDOWNER: Red Adams  
Rt. 3  
Caldwater, Mrs.  
(mailing address)

description of formations encountered	from to	
<u>Red Clay</u>	<u>0</u>	<u>15</u>
<u>Red Sand + clay</u>	<u>15</u>	<u>90</u>
<u>White Sand</u>	<u>90</u>	<u>140</u>

WELL LOCATION:  
sec. 33 T. 4 N. R. 5 E  
2 miles E of Bett  
(distance) (direction) (nearest town)

WELL PURPOSE: Home  
(home, irrigation, municipal, industrial)

- WELL COMPLETION DATA:
- (1) diameter (inches) 4
  - (2) total depth (feet) 140
  - (3) static water level (feet) 90 below top of ground.
  - (4) casing PVC 140  
(material) (depth)
  - (size) if telescope see back.
  - (5) screen 7' 133'  
(length) (depth to top)
  - 4" gravel type  
(size) (material)
  - (6) pump 1/2 10  
(HP) (yield gpm)
  - 220V  
(type power)
  - (7) electric log No  
(yes or no)
  - (organization running log)
  - (8) how well bottom plugged Cap

DRILLERS REMARKS:


RECEIVED

FEB 27 1978

MISS. BD. OF WATER COMMISSIONERS

If well telescopes please sketch and show depths.

GROUND LEVEL

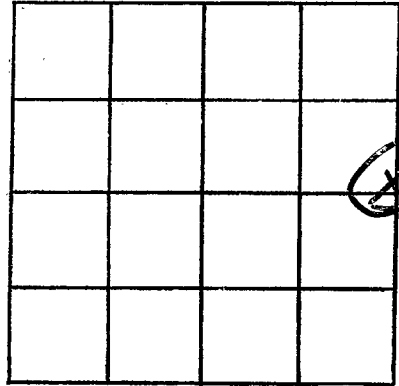

SECTION 33

Please indicate well location X.

ADDITIONAL INFORMATION

If more than one screen, show locations of each on sketch.