

TATE
D
2020

**MISSISSIPPI
BOARD OF WATER COMMISSIONERS**
416 North State Street
Jackson, Mississippi 39201

WATER WELL DRILLERS LOG

4-5-78 1978 *Bob Smiley* *Tate*
 date well completed firm name county well located

LANDOWNER:	description of formations encountered	from	to
<i>Betty Powder</i> <i>Collins, Ms</i> (mailing address)			
WELL LOCATION: sec. <i>31</i> T <i>4</i> N R <i>6</i> S <i>0</i> miles <i>0</i> of <i>Betta</i> (distance) (direction) (nearest town)			
WELL PURPOSE: (home) irrigation, municipal, industrial			
WELL COMPLETION DATA:			
(1) diameter (inches) <i>4"</i>			
(2) total depth (feet) <i>140</i>			
(3) static water level (feet) <i>60</i> below top of ground			
(4) casing <i>plastic</i> <i>140</i> (material) (depth)			
(size) if telescope see back.			
(5) screen <i>10</i> <i>130</i> (length) (depth to top)			
<i>4"</i> <i>plastic</i> (size) (material)			
(6) pump <i>3/4</i> <i>10</i> (HP) (yield gpm)			
<i>V. her</i> (type power)			
(7) electric log (yes/or no)			
(organization running log)			
(8) how well bottom plugged			
DRILLERS REMARKS:			


RECEIVED

MAY 30 1978

MISS. BD. OF WATER COMM

If well telescopes please sketch and show depths.

GROUND LEVEL

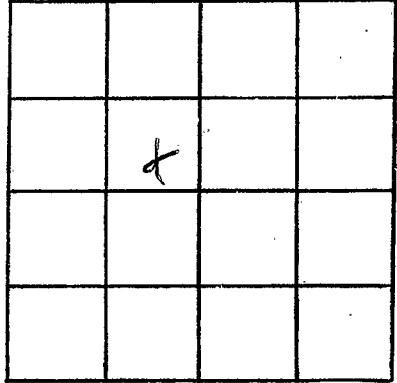

SECTION _____

Please indicate well location X.

ADDITIONAL INFORMATION

If more than one screen, show locations of each on sketch.